


T. 17 S., R. 5 W., W.M.

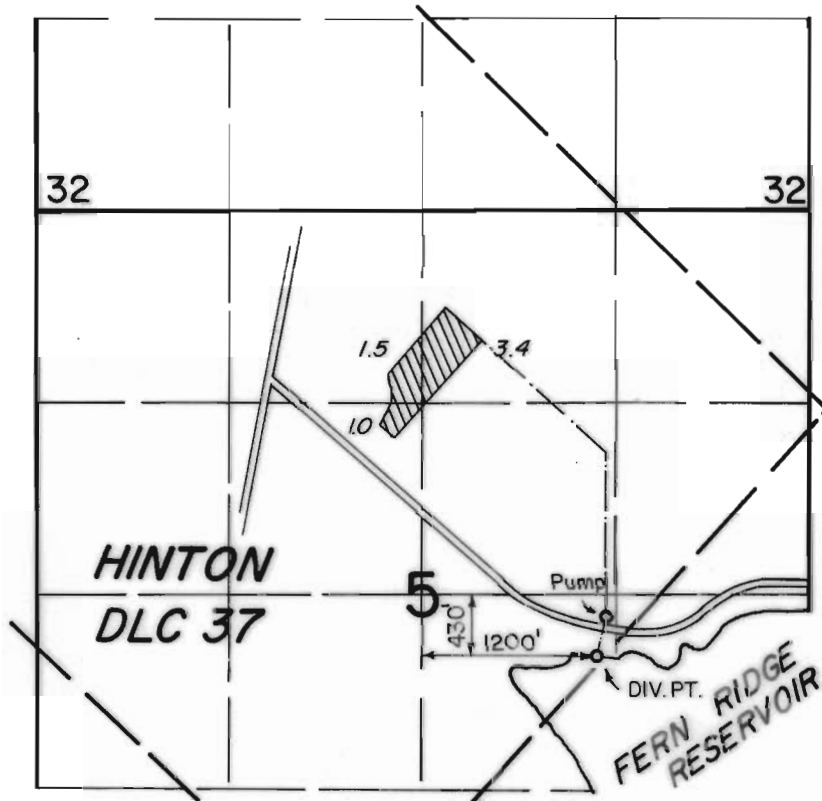

FINAL PROOF SURVEY
UNDER

Application No. 51680 Permit No. 38966
IN NAME OF

S. R. & L. M. EGETER

Surveyed MAY 9, 1978, by L. NUNN