


T.16S. R.5W. W.M.

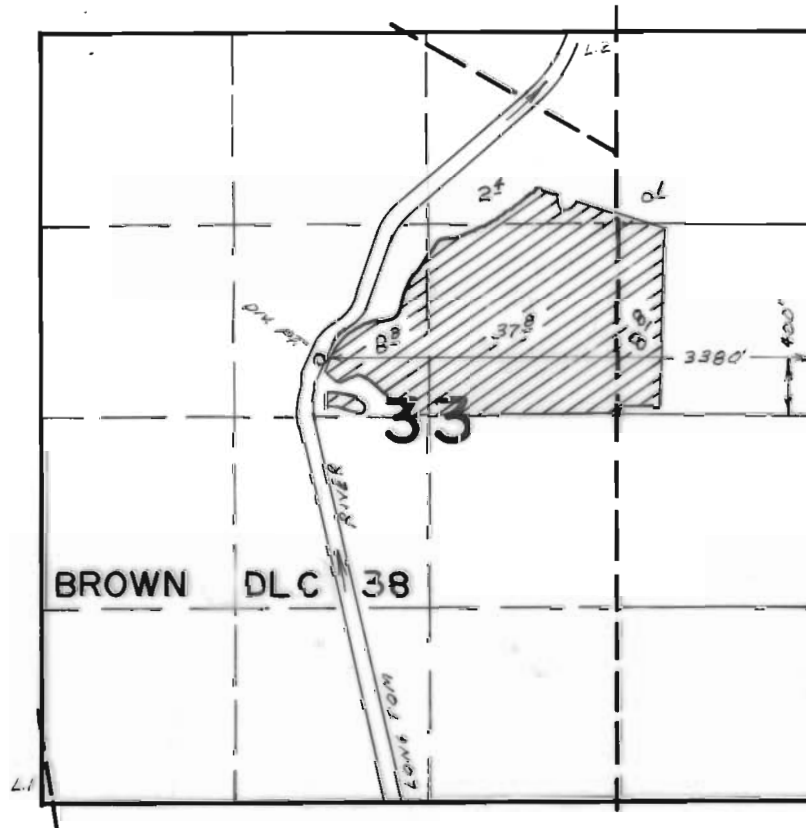

FINAL PROOF SURVEY
UNDER

Application No. 52828... Permit No. 40596...
IN NAME OF

TAYLOR RAMSEY

Surveyed MAY 11, 1978, by L.H. NUNN