


T.17S., R.6W., W.M.

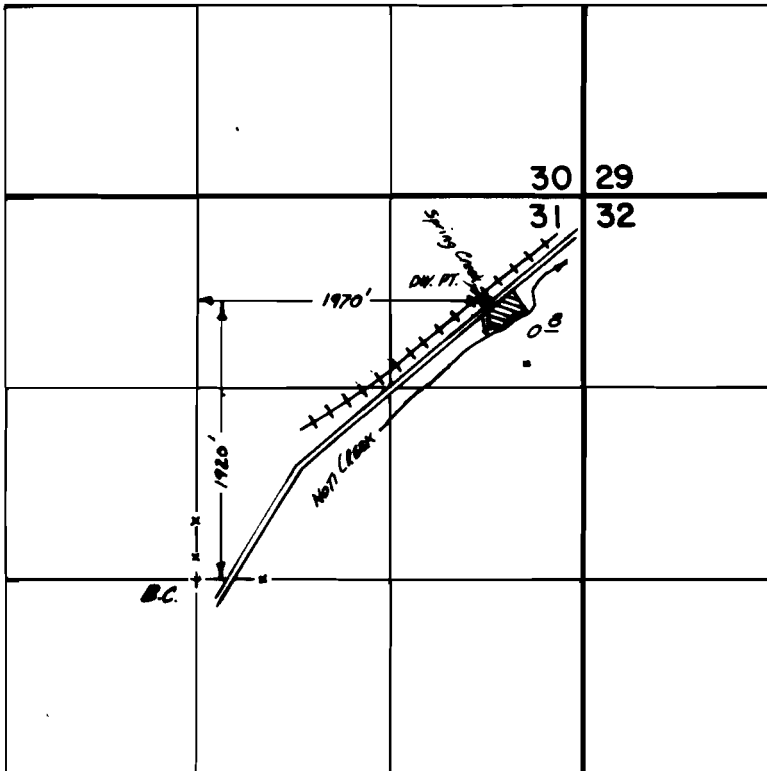

FINAL PROOF SURVEY
UNDER

Application No. 53508 Permit No. 40052

IN NAME OF

Vincent J. Claric

Surveyed May 12, 1978 by L. H. Nunn