


T. 7 S., R. 10 W., W.M.

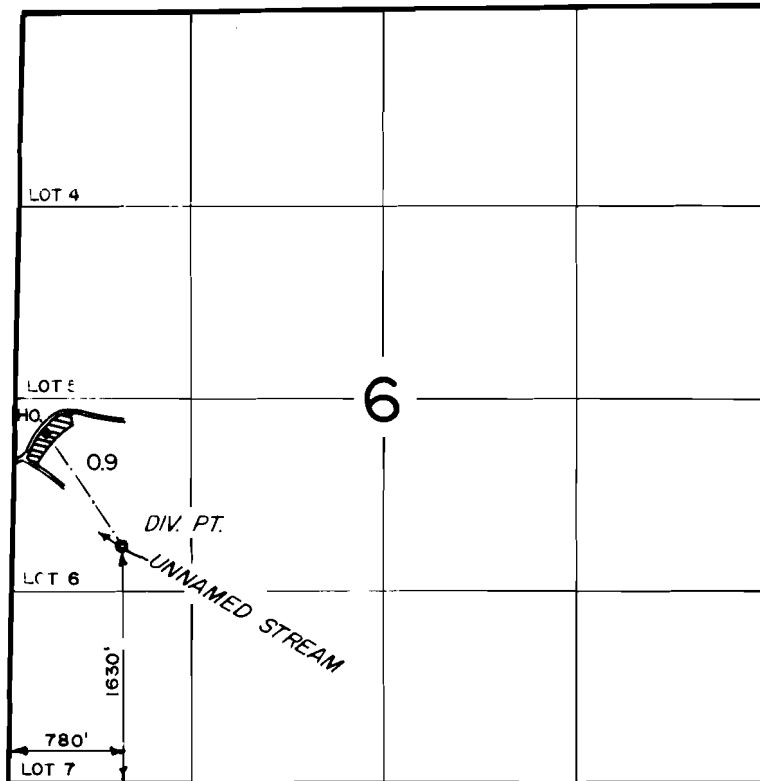

**FINAL PROOF SURVEY**  
UNDER

Application No. 45829 Permit No. 34199  
IN NAME OF

S.F. & F.A. Sauer

Surveyed May 17, 1978, by L. Nunn