


T.9S. R.1W. W.M.

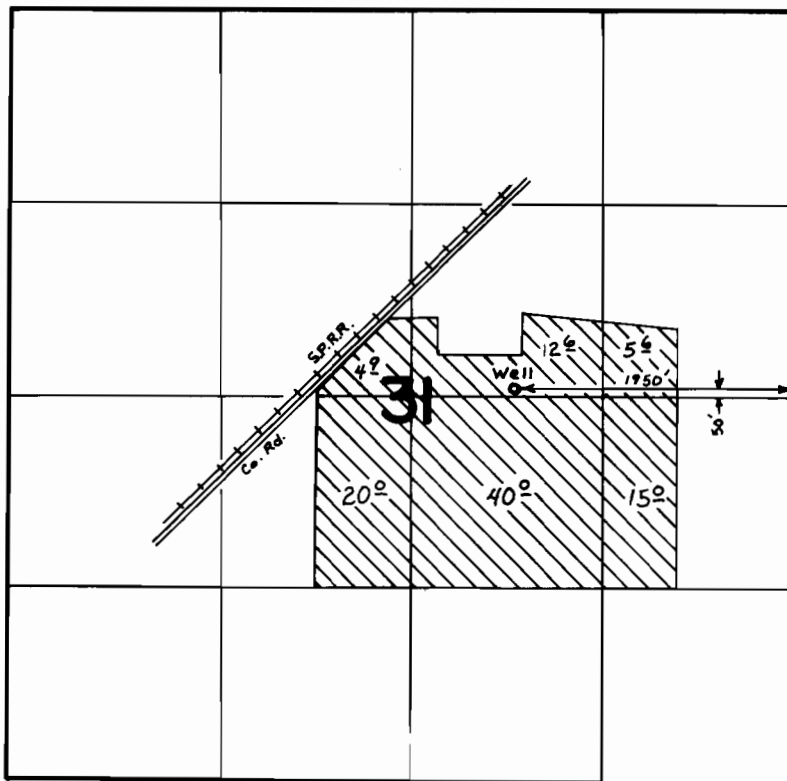

FINAL PROOF SURVEY
UNDER

Application No. G-7213 Permit No. G-6636
IN NAME OF

RICHARD SCHUMACHER

Surveyed AUG. 11, 1977, by D. NORBY