


T.9S., R.3E., W.M.

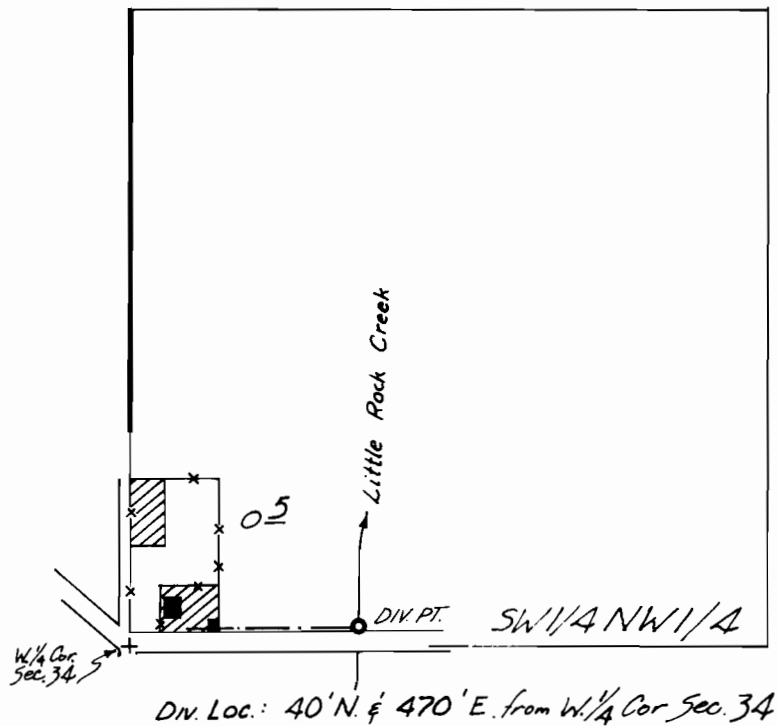

Scale 1" = 400'

FINAL PROOF SURVEY
UNDER

Application No. 42992 Permit No. 32122
IN NAME OF

FRANK & DOROTHY NOVAK

Surveyed April 26, 1979, by AC Brown