


T.18S,R.46E.,W.M.

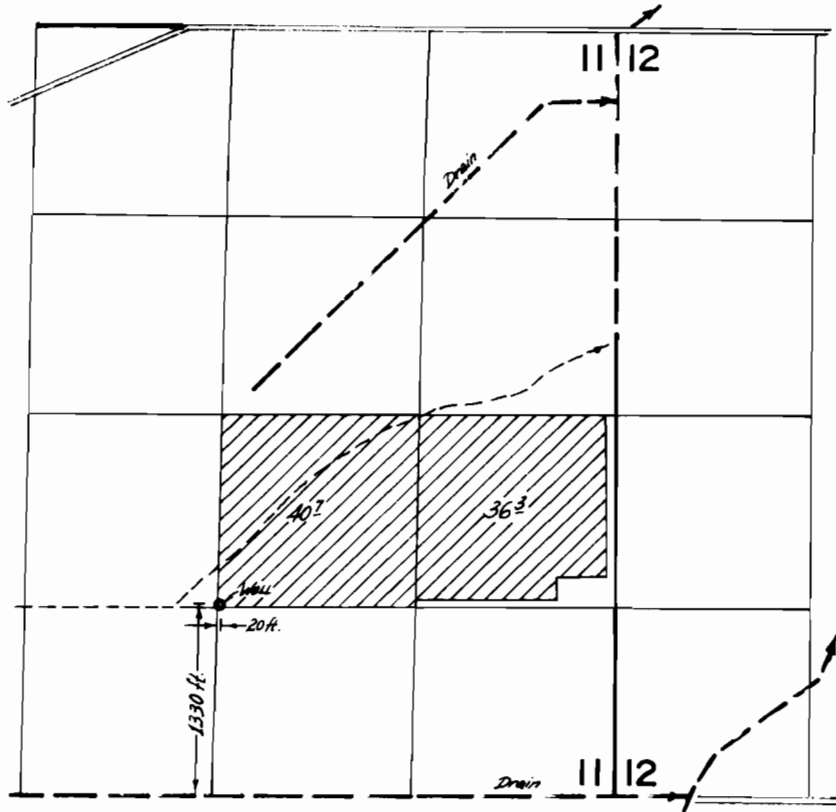

**FINAL PROOF SURVEY**  
UNDER

Application No. G-1138 Permit No. G-1178  
IN NAME OF

JOHN TURNBULL

Surveyed 12 June 1962, by C. Baker