


T.18S. R.43E. W.M.

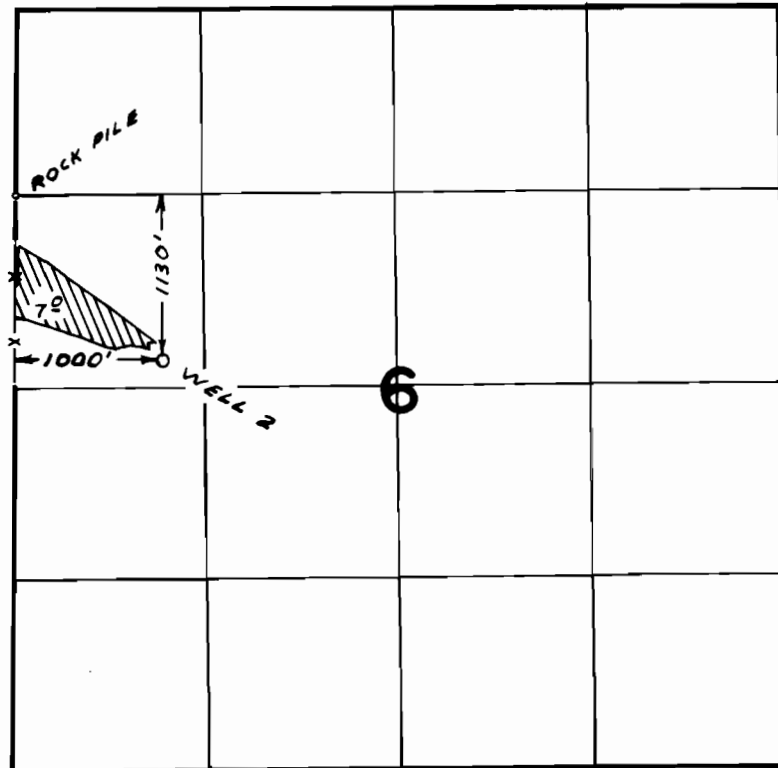

FINAL PROOF SURVEY
UNDER

Application No. G-5928. Permit No. G-5635.
IN NAME OF

ESTATE OF GROVER FOSTER

Surveyed JUN. 28. 1978., by L.H. NUNN