


# T.14S. R.39E. W.M.

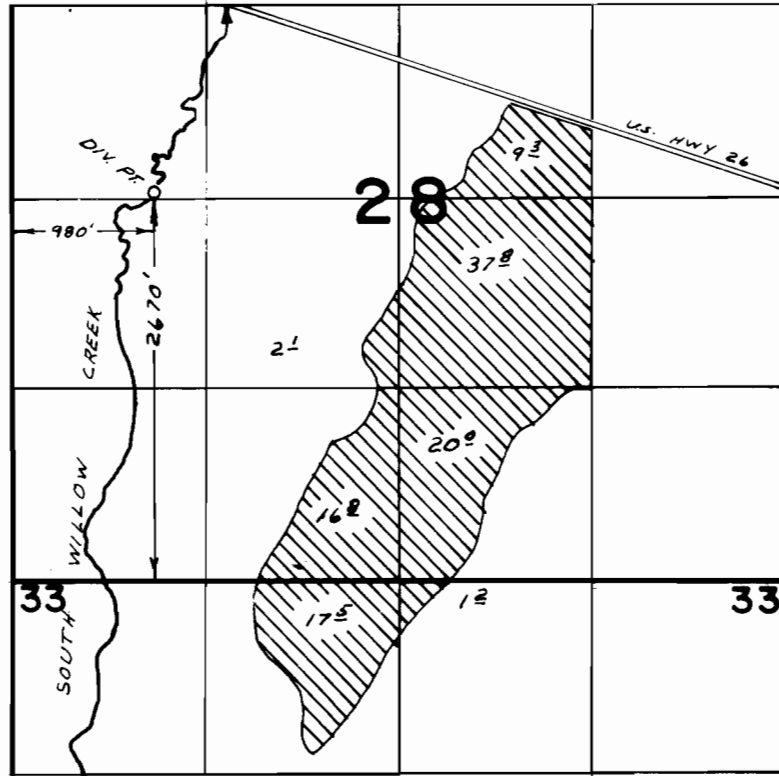

## FINAL PROOF SURVEY UNDER

Application No. 49000 Permit No. 36682  
IN NAME OF

RAYMOND M. & V. FERNE DUNCAN

Surveyed JUN. 23. 1978. by L.H. NUNN