


T.19S.R.47E.W.M.

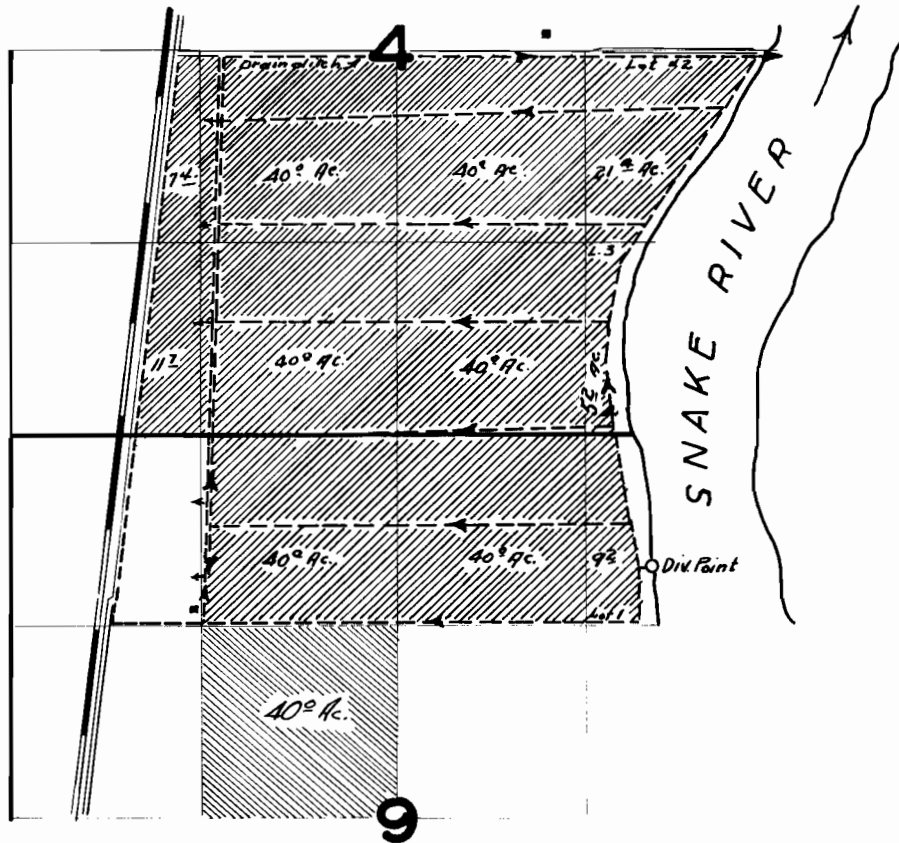

APP. 23967 PER.18916



FINAL PROOF SURV.

UNDER

23967

18916

Application No. 22766 . Permit No. 17871

IN NAME OF

W. H. SHEARMAN, TRUSTEE

Surveyed 8 / 25 . . 1951 . . by H.L. COFFMAN