


T.7S. R.IW. W.M.

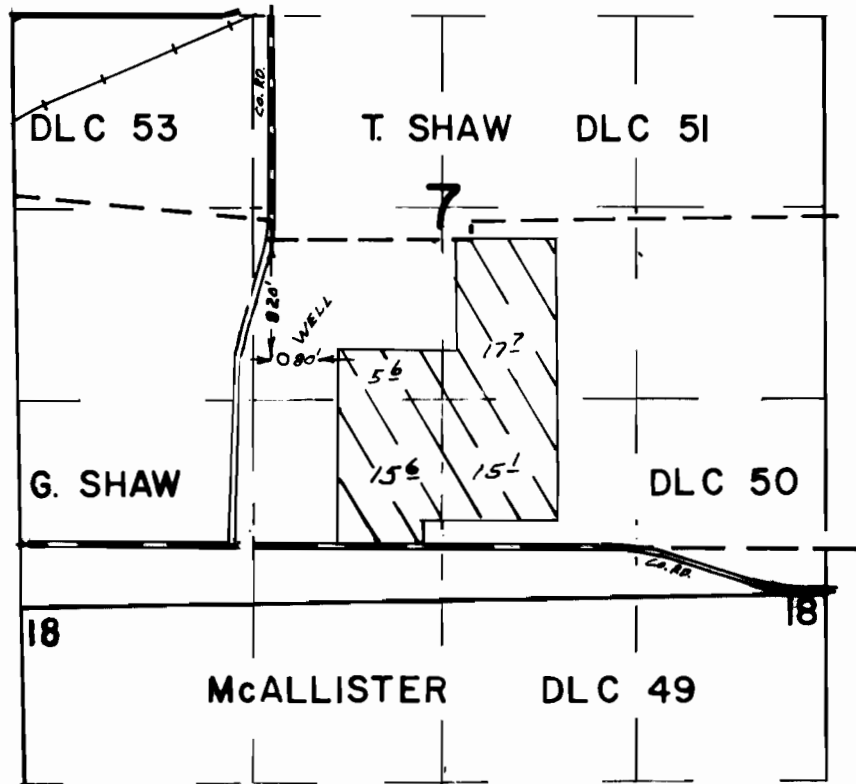

FINAL PROOF SURVEY UNDER

Application No. G-6097. Permit No. G-5778.
IN NAME OF

CLIFFORD HERR

Surveyed APR. 12. 1977. by L.H. NUNN