


T. 4S. R. 2 & 3W. W.M.

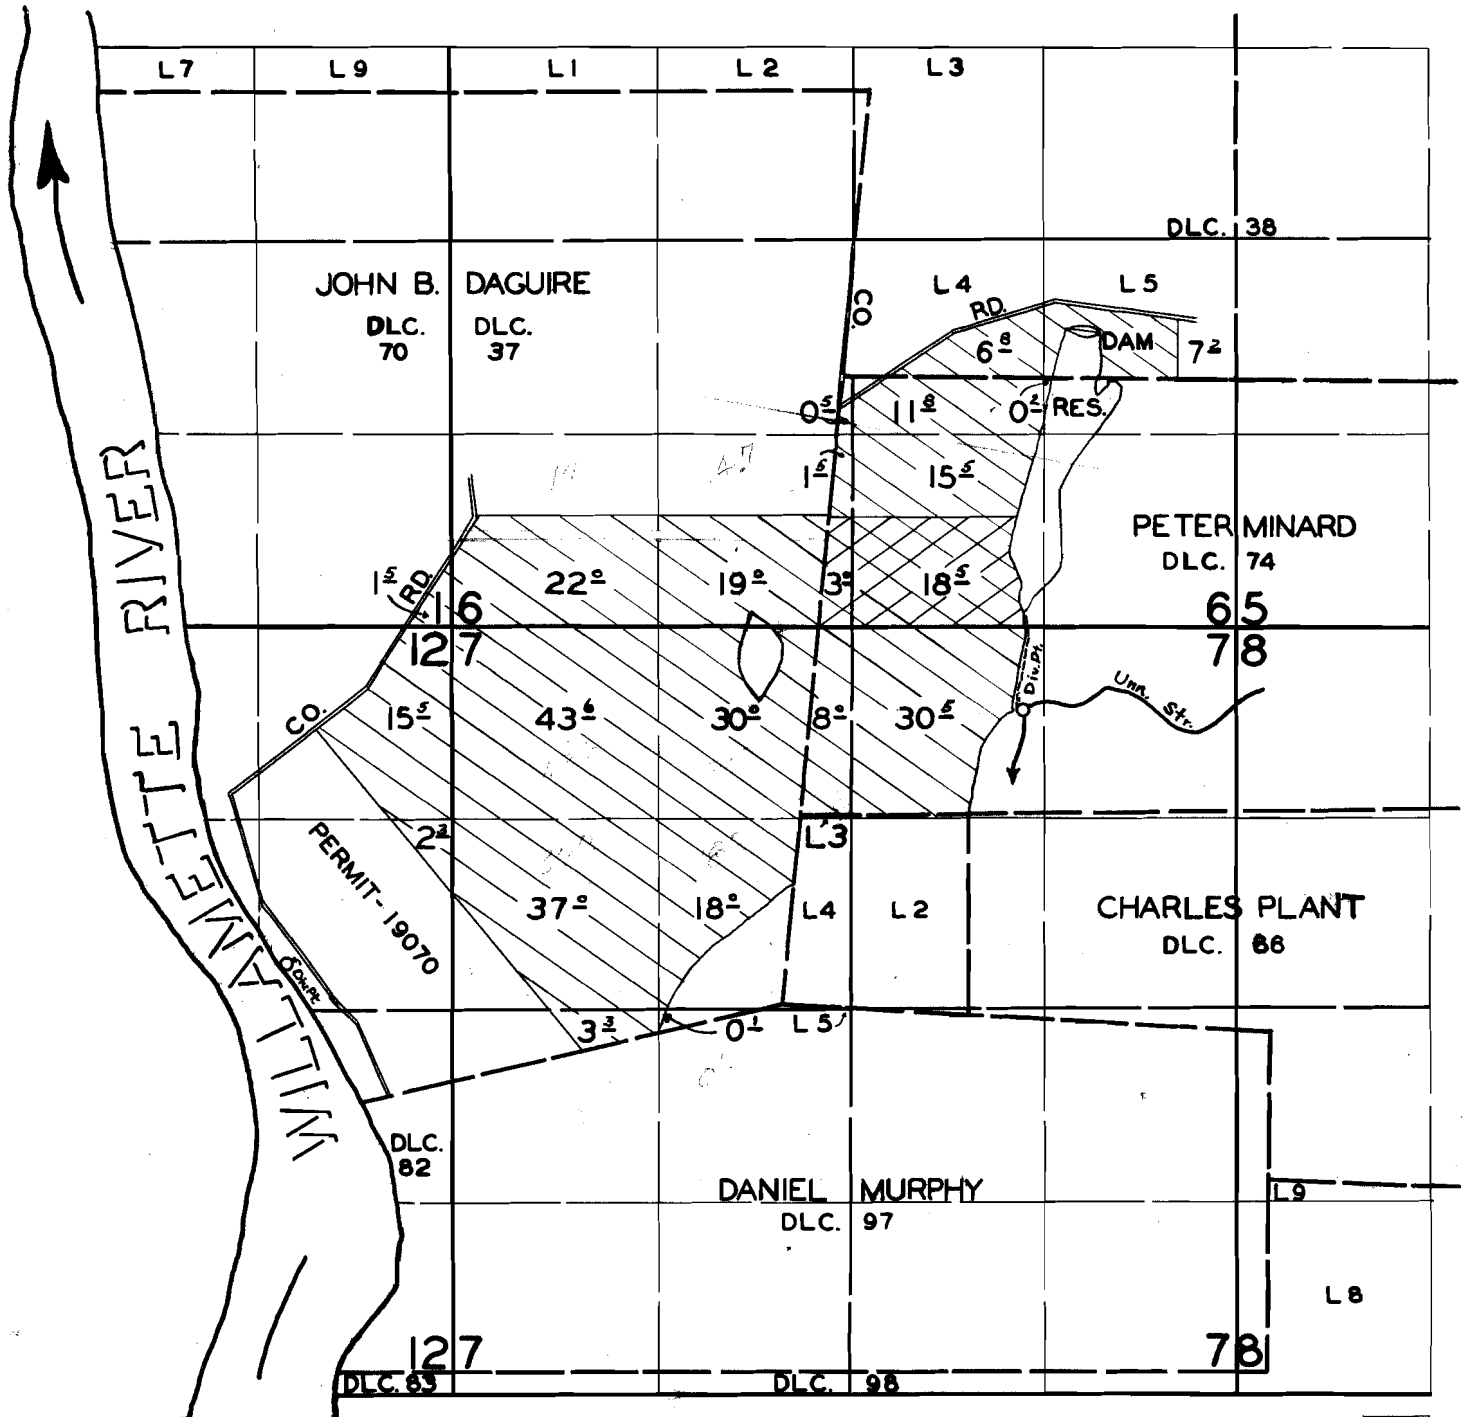

FINAL PROOF SURVEY

UNDER

R-25535

R-1145

Application No. 25536

Permit No. 20223

IN NAME OF

JOHN L. & CATHERINE ANN MARXER

Surveyed 2 MAR. 1956, by R.D. BEST.

PRIM. -

SUPPL. -

RDB