


T.3N.,R.2W.,W.M.

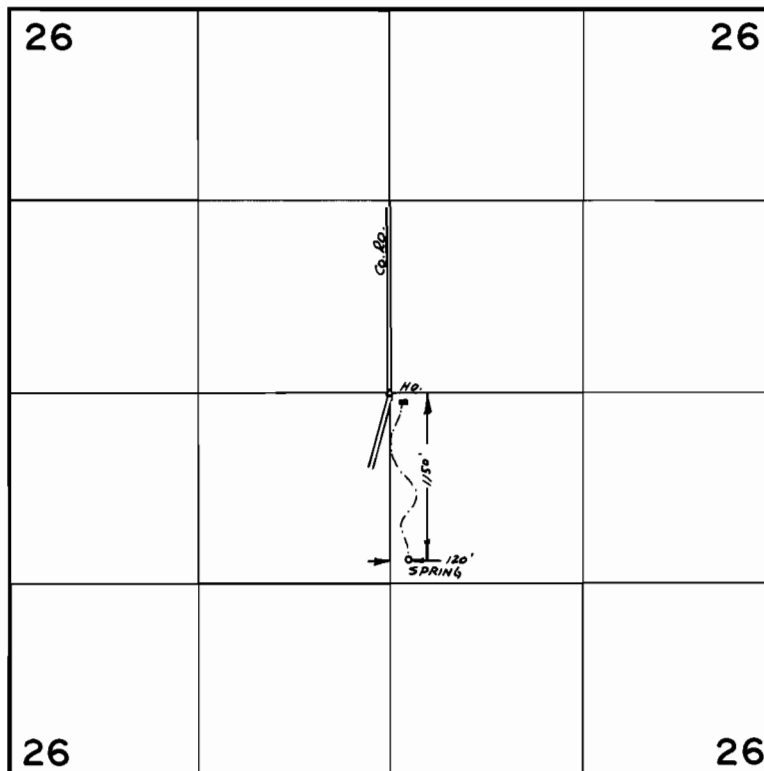

FINAL PROOF SURVEY
UNDER

Application No. 33346 Permit No. 26316
IN NAME OF

MR. & MRS. BRADLEY S. PUTMAN

Surveyed JUNE 7 1976, by L. Tsch