T.7S.,R.4W.,W.M.

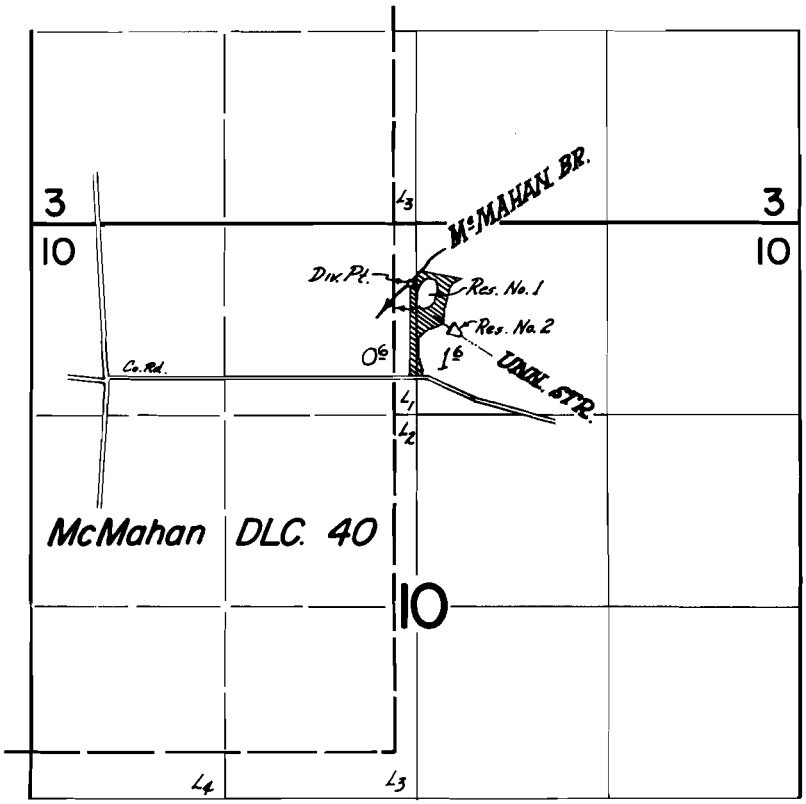

Div. Pts. located: McMahan Br.-410'S. & 40'W.; Unn. Str.-730'S. & 230'E.; both from N. 1/4 cor. Sec. 10.

FINAL PROOF SURVEY

UNDER

R-52077	R-6284
52078	39241
R-52079	R-6285

Application No. 52080 Permit No. 39242

IN NAME OF

KENNETH WAYNE & JOAN ERICKSON

Surveyed Aug. 11 1977, by L.M. Toll

1977-U & DFP-2LL-178