


T.6S.,R.6W.,W.M.

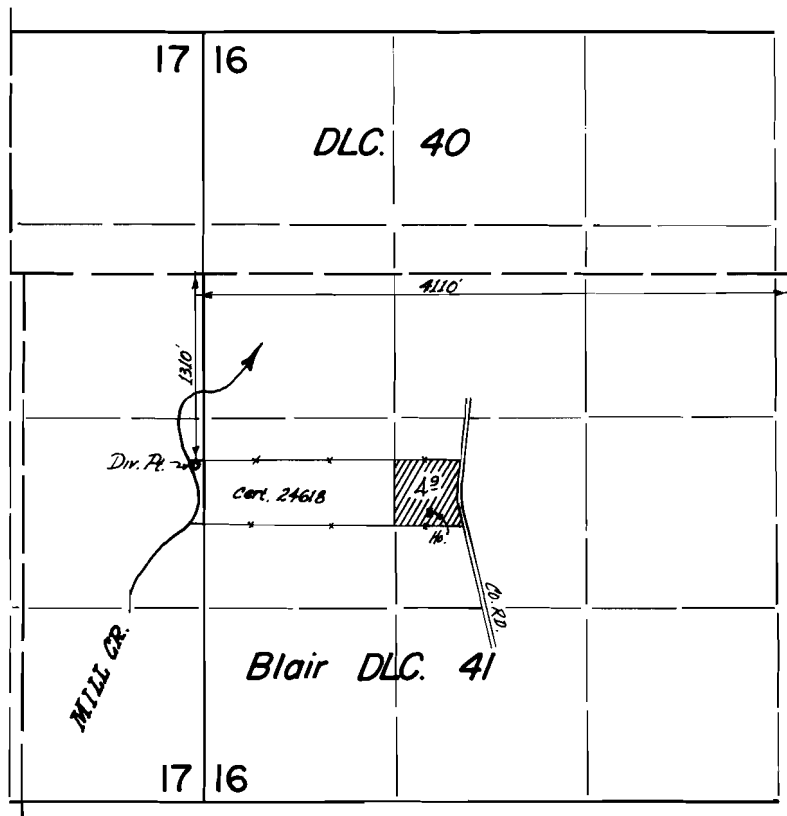

**FINAL PROOF SURVEY**  
UNDER

Application No. 53256 Permit No. 39521...  
IN NAME OF

LARRY E. MOHLER

Surveyed Aug. 9, 1917, by L.M. TOLL