


T.2N. R.32E. W.M.

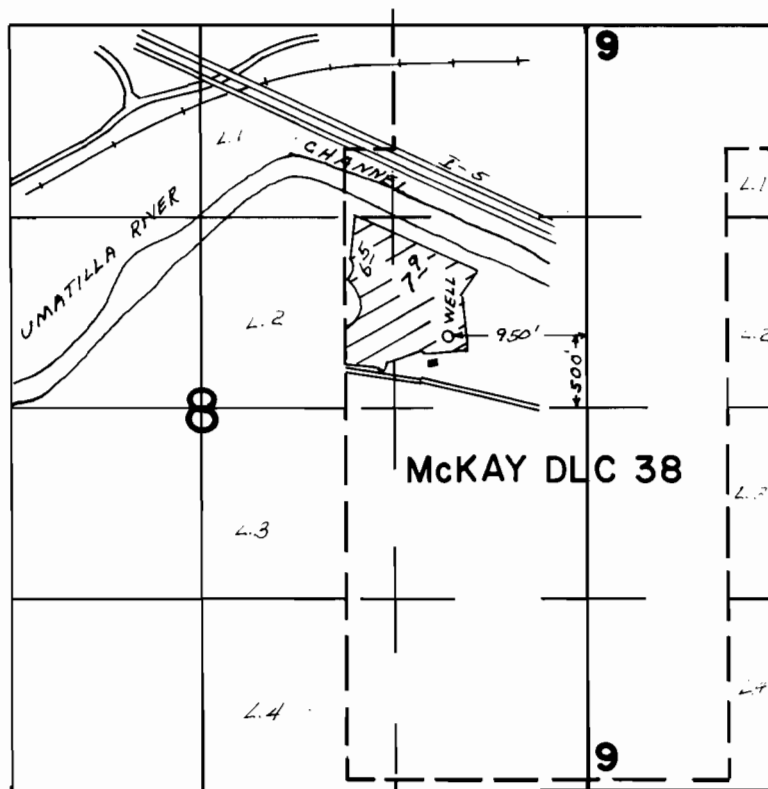

**FINAL PROOF SURVEY**  
UNDER

Application No. G-6605... Permit No. G-6188...  
IN NAME OF

.....JAMES L. & LAUREL COX.....

Surveyed MAY 4... 1977., by L.H.NUNN.....