


T.5S. R.11 & 12E. W.M.

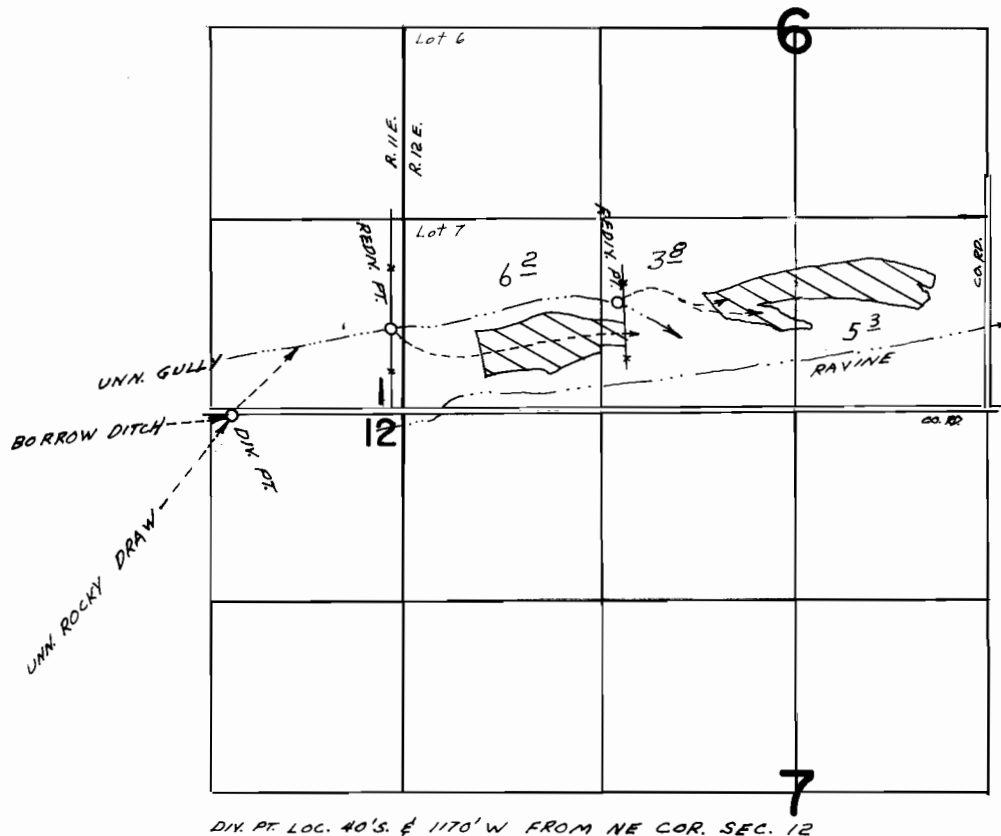

FINAL PROOF SURVEY
UNDER

Application No. 49797 Permit No. 37463
IN NAME OF

ESTATE OF JOHN KOHL

Surveyed NOV. 3 1977, by L.H. NUNN