


## T.2N.R.12E.W.M.

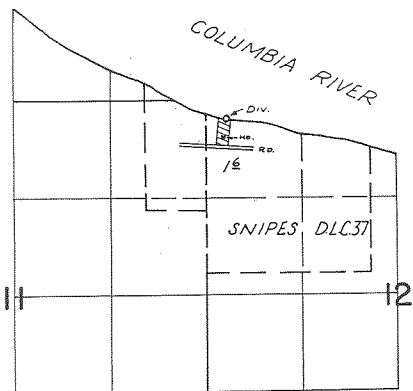

DIV. LOC: 250'S. + 280'E. FROM N.W. COR. SEC. 12

**FINAL PROOF SURVEY**  
UNDER

Application No. 50254..... Permit No. 37500..  
IN NAME OF

.....JAMES A. MARINO.....

Surveyed APR. 6, 1976, by R. MUCKEN