


T.2S.R.1W.W.M.

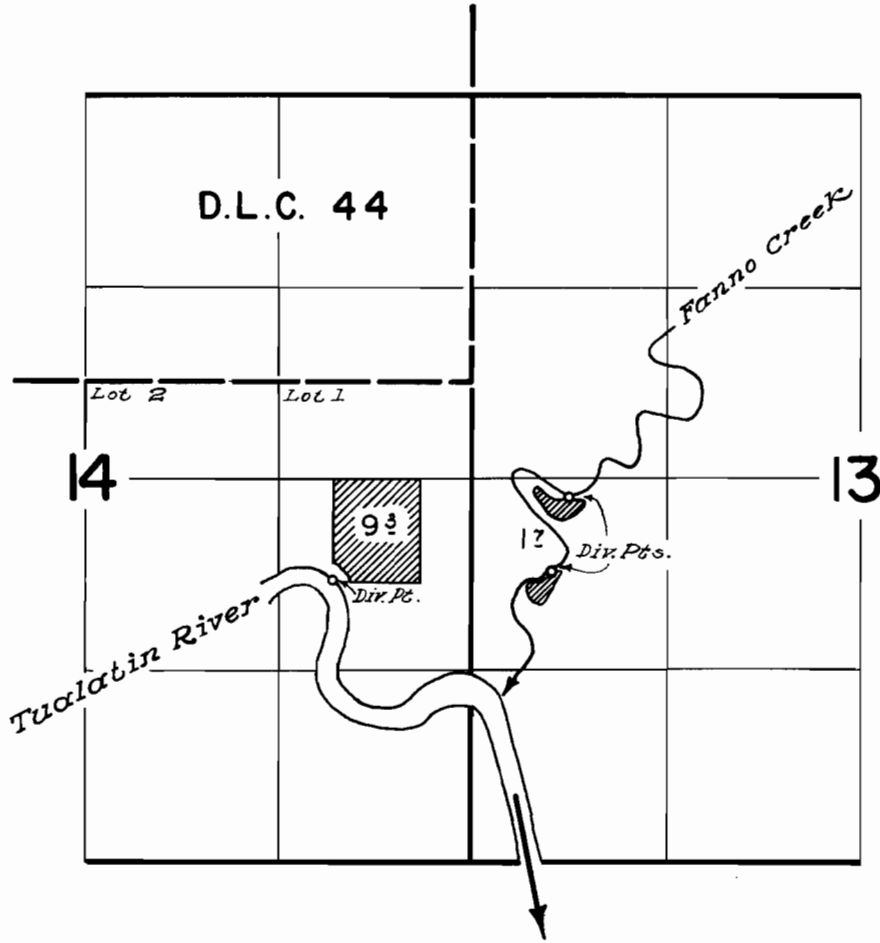

**FINAL PROOF SURVEY**  
UNDER

Application No. 30.11.7... Permit No. 23.7.7.1  
IN NAME OF

**HENRY S. MEARS**

Surveyed May 23, 1960, by