


T.5S.R.3W.W.M.

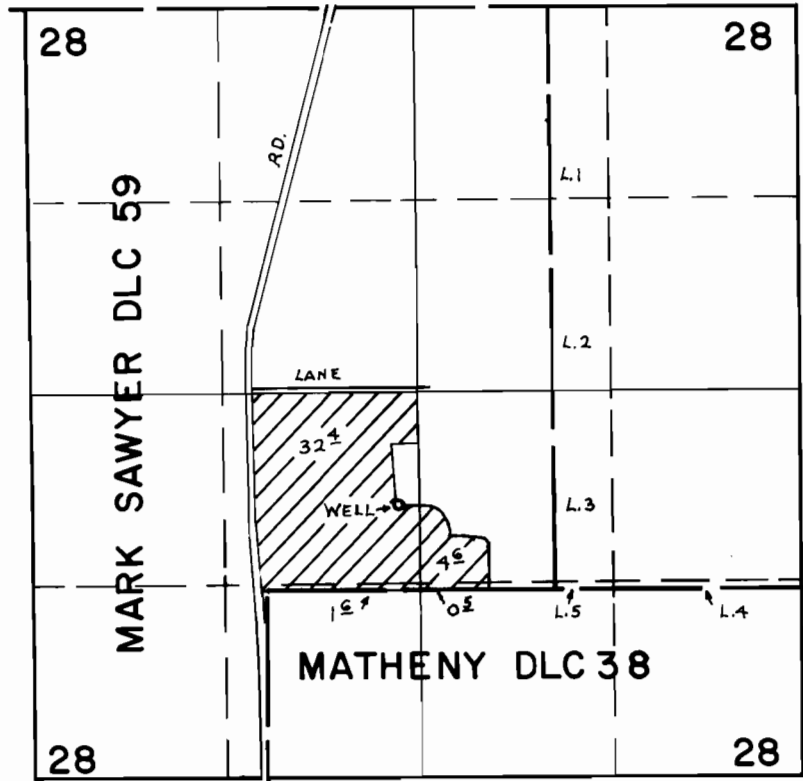

WELL LOC. - 770'S. & 140' W. FROM CENTER SEC. 28

FINAL PROOF SURVEY UNDER

Application No. G-6366 Permit No. G-5962
IN NAME OF

FRED. BAUER

Surveyed June 1, 1976, by R.G. Mucken