


T.2&3S.,R.2W.,W.M.

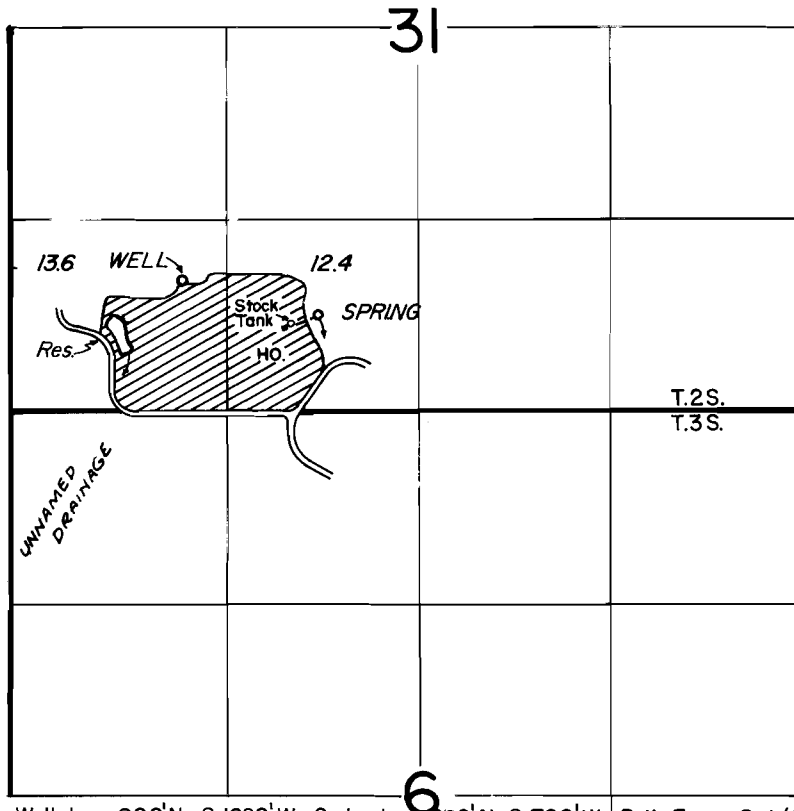

Well Loc.: 900' N., & 1620' W.; Spring Loc.: 660' N., & 700' W.; Both From S. 1/4
 Cor. Sec. 31; RES. DIV. Loc.: 400' N. & 2000' W. FROM S. 1/4 COR. SEC. 31

FINAL PROOF SURVEY

UNDER

R-48203 R-5813
 48204 35960
 50063 37627

Application No. G-7593 Permit No. G-7052

IN NAME OF

JOHN KROO

Surveyed MAY 2., 1978, by L. NUNN