


T. 7S. R. 45E. W.M.

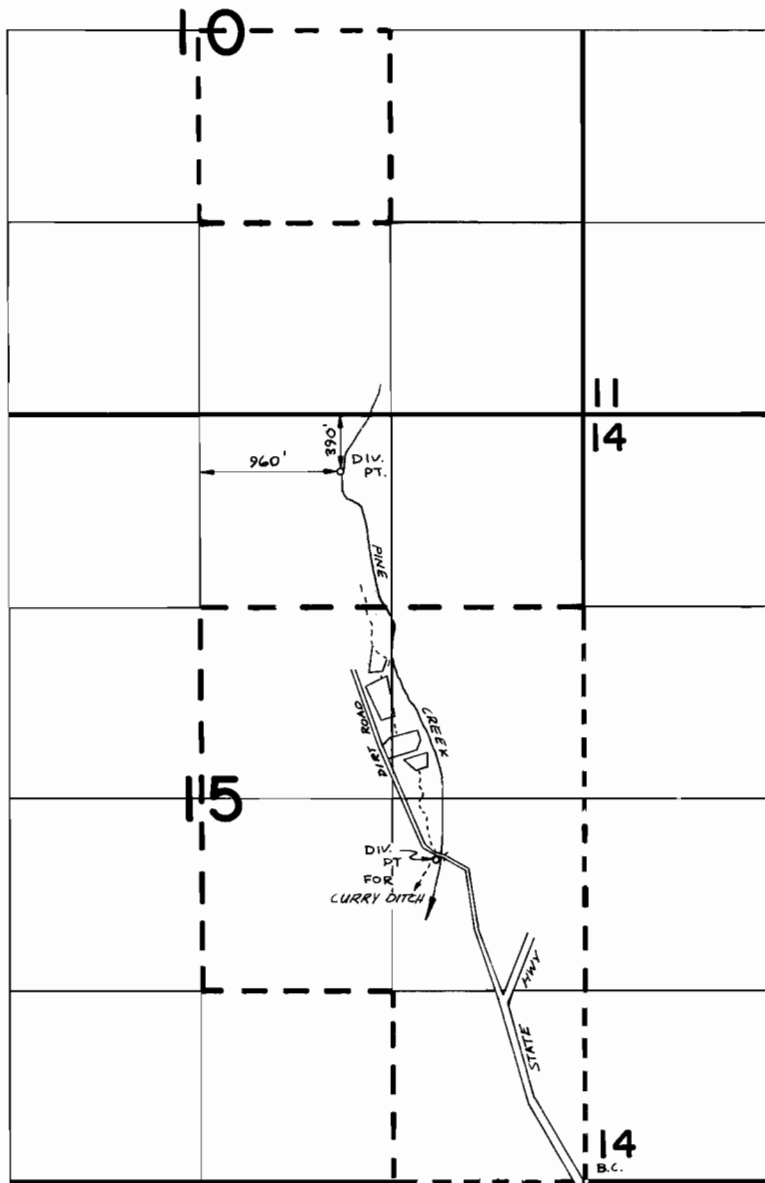

FINAL PROOF SURVEY
UNDER

Application No. 28386 Permit No. 26604
IN NAME OF

DAVID STEINMETZ

Surveyed 5-24 1978, by R. BARWIN