


T.15S.R.5W. W.M.

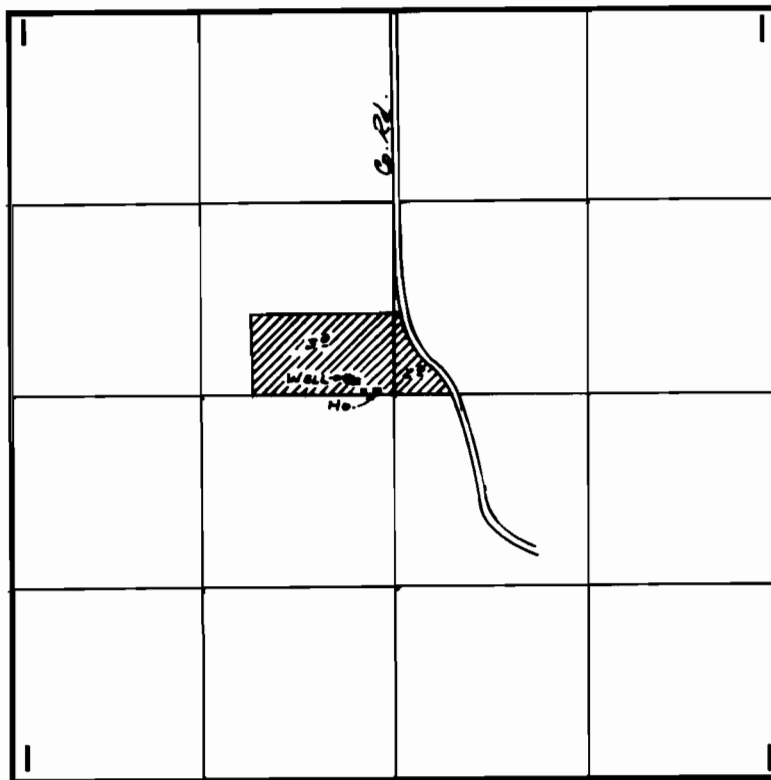

WELL LOC. 120' N. & 320' W FROM CENTER SEC. 1

FINAL PROOF SURVEY
UNDER

Application No. G-5783. Permit No. G-7718.
IN NAME OF

WILLIAM H. & JANET E. KERRIGAN

Surveyed March 20 1978, by J.S. Donaldson...