


T. 14S. R. 5W. W.M.

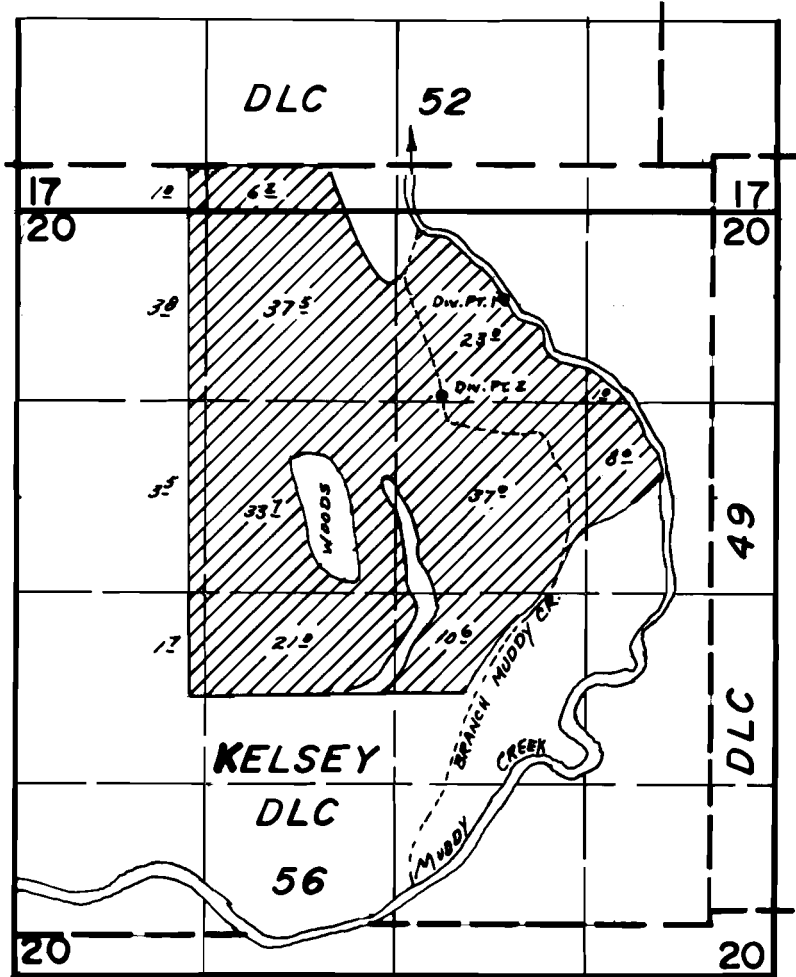

Div. Pt. #1 - 600' S & 194' W } BOTH FROM NE COR. SEC. 20
 Div. Pt. #2 - 1260' S & 2320' W }

FINAL PROOF SURVEY UNDER

Application No. 54380. Permit No. 41181.....
 IN NAME OF

.....PRINCE V. & IRENE BAKER.....

Surveyed March 20 1978., by J.S. Donaldson.