


T. 3 S., R. 3 E., W.M.

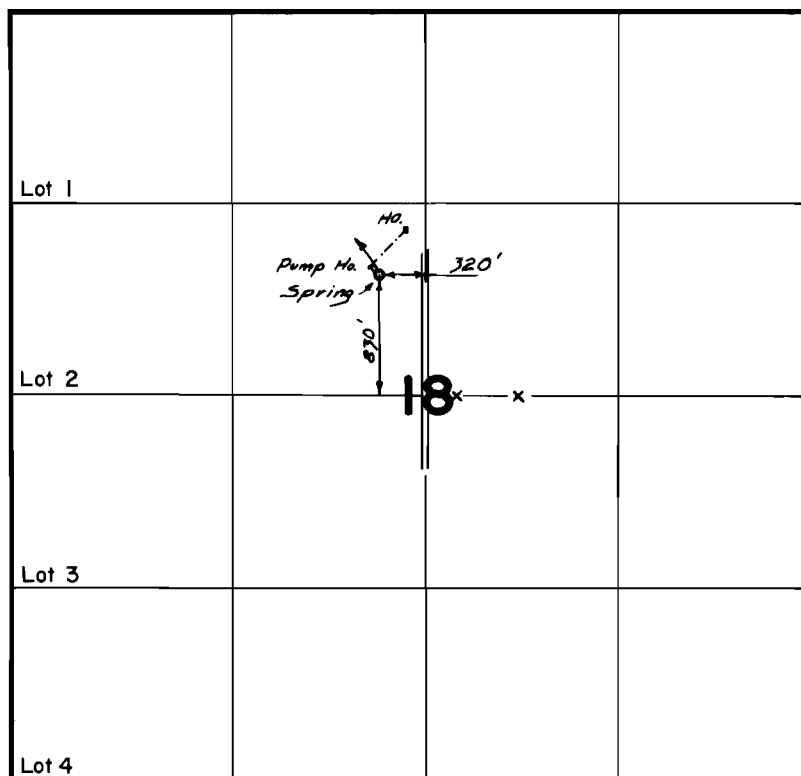

FINAL PROOF SURVEY
UNDER

Application No. 55276 Permit No. 41477
IN NAME OF

Leo D. & Eva J. Johnson

Surveyed Feb. 8, 1978, by d.C. Brown