


T.5N.,R.3W.,W.M.

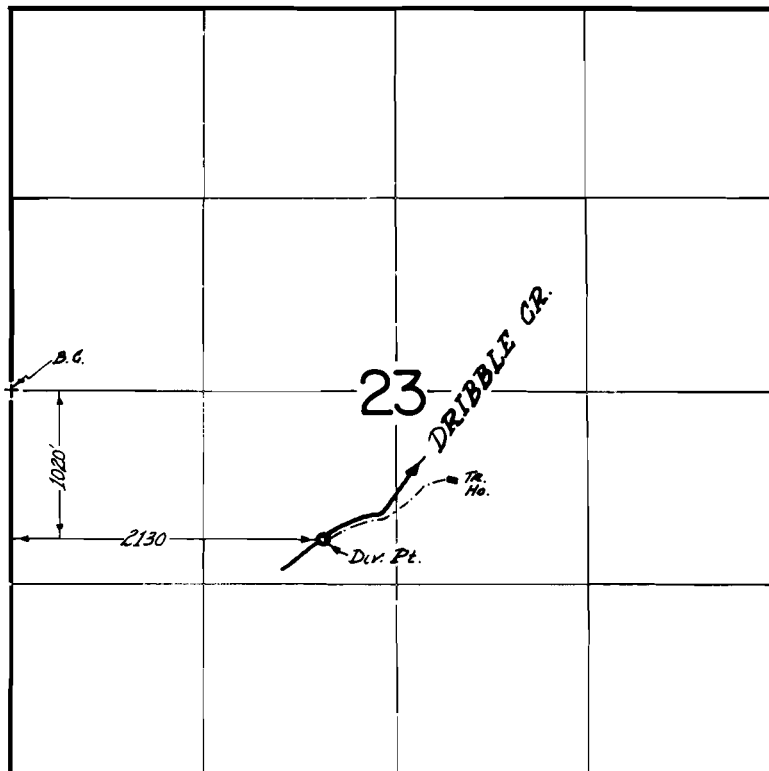

FINAL PROOF SURVEY
UNDER

Application No. 54381 Permit No. 40755
IN NAME OF

RUDOLPH M. & FLORENCE S. BAUDER

Surveyed Sept 19 1978 by *AB Applegate*