


T.25S., R.5W., W.M.

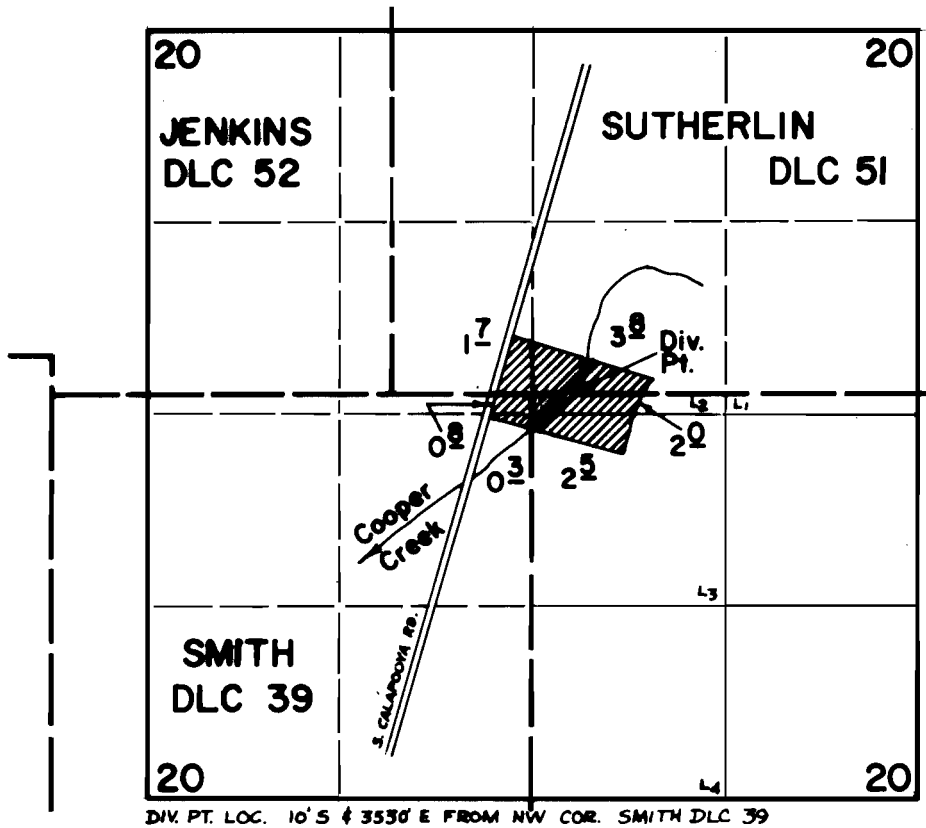

**FINAL PROOF SURVEY**  
UNDER

Application No. 52170 Permit No. 37857  
IN NAME OF

TONY STANLEY

Surveyed July 30 1976, by D. Norby