


T. 1 N., R. 11 E., W. M.

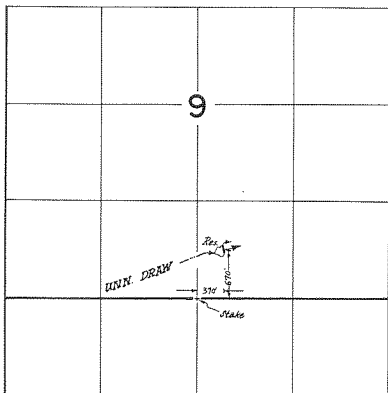

FINAL PROOF SURVEY
UNDER

R-46450 R-5533
Application No. 46501 Permit No. 34719
IN NAME OF

VIRGIL M. & F. PAULINE ELLETT

Surveyed *May 11* 1978, by *A. P. Applegate*