


T.1N.,R.1E.,W.M.

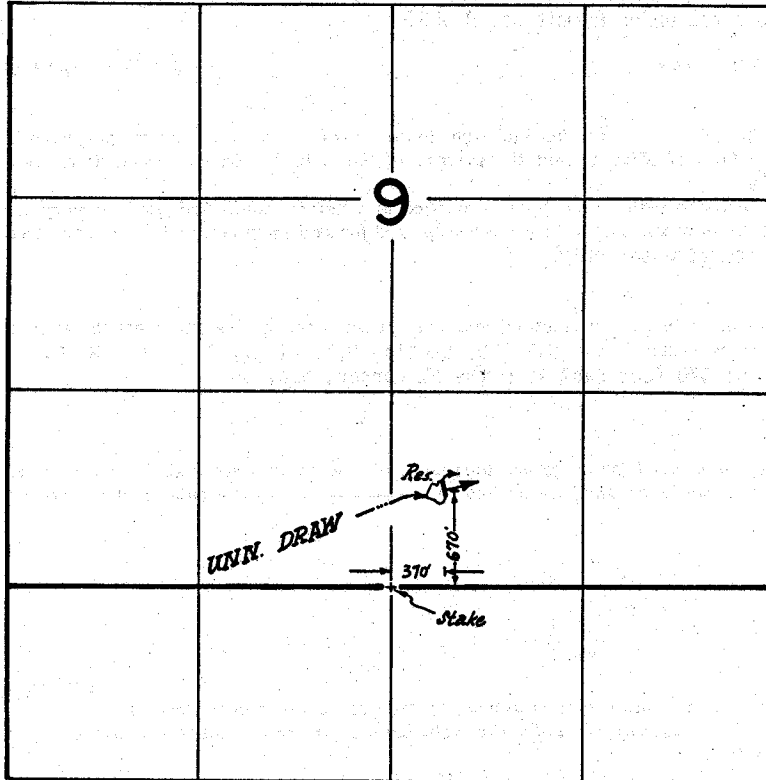

FINAL PROOF SURVEY UNDER

R-46450 R-5533
 Application No. 46501 Permit No. 34719
 IN NAME OF

VIRGIL M. & F. PAULINE ELLETT

Surveyed *May 11* 1978 by *A. G. Applegate*