


TIN. R. IOE. W.M.

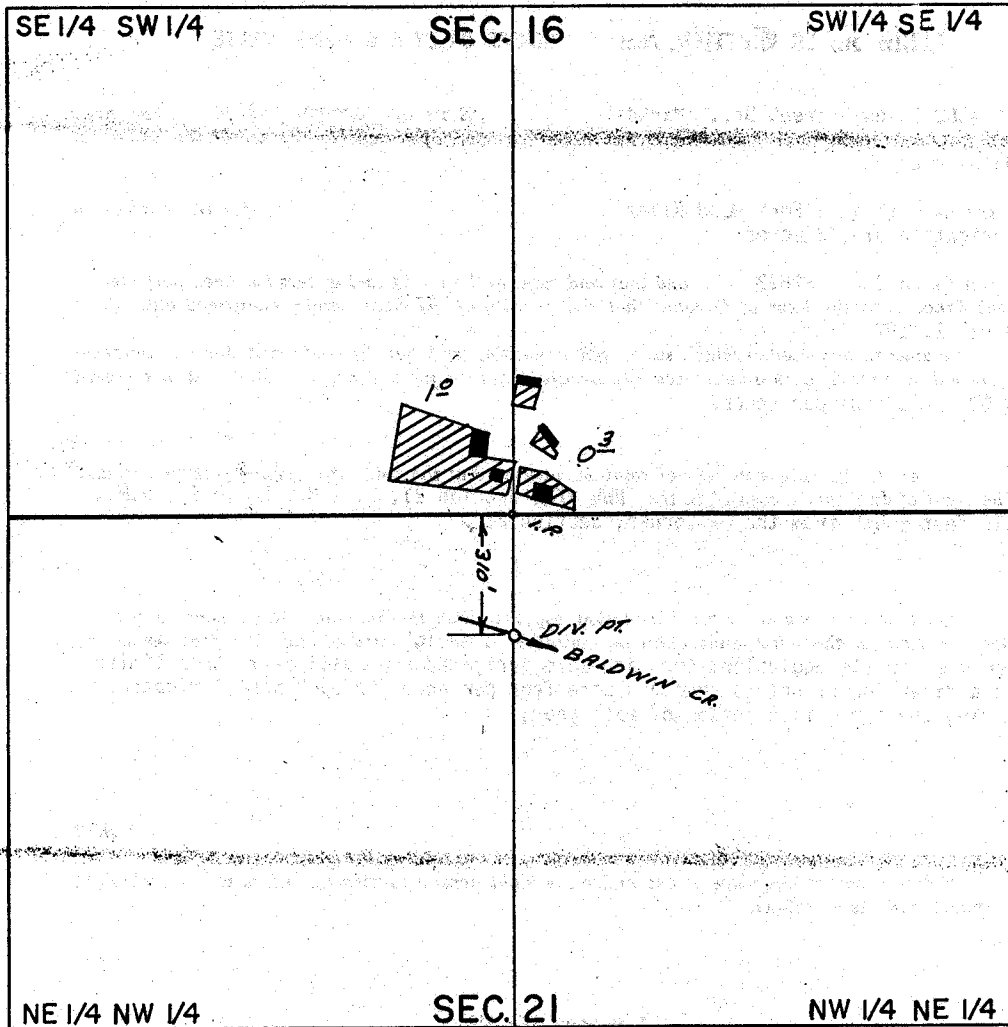

1" = 500'

**FINAL PROOF SURVEY**  
UNDER

Application No. 50245... Permit No. 37893...  
IN NAME OF

**HOWARD DALEY & JAMES WILLIE**

Surveyed OCT. 27. 1977, by L.H. NUNN.....