


T. 32 S., R. 3 E., W.M.

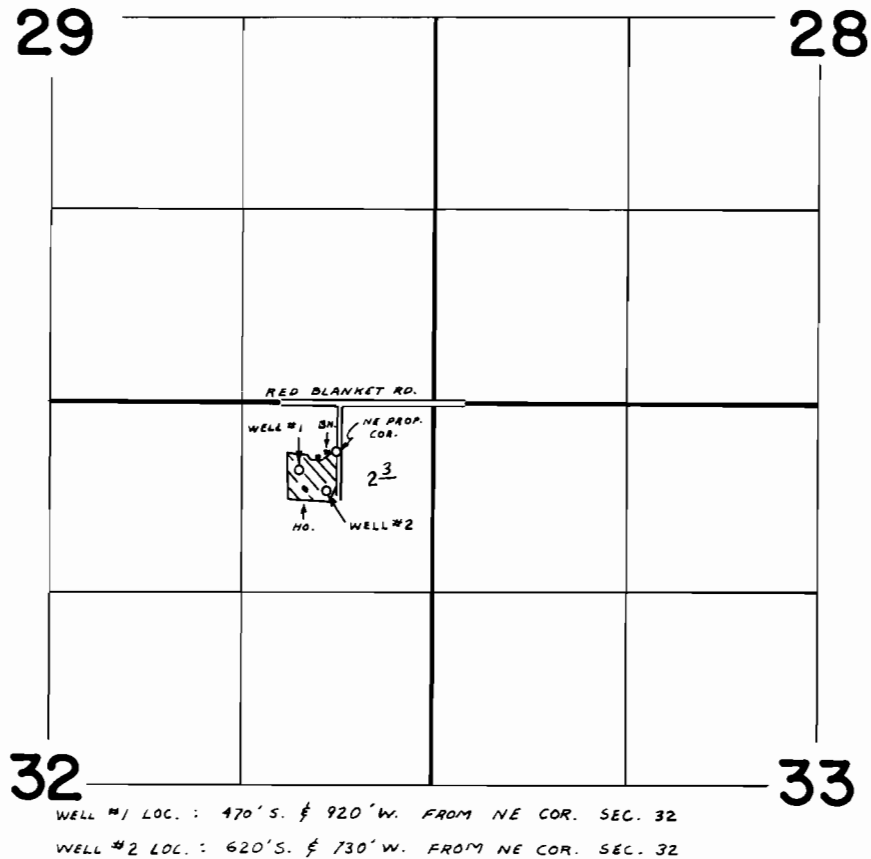

FINAL PROOF SURVEY
UNDER

Application No. G-7342 Permit No. G-6775
IN NAME OF

SAM FRICKE

Surveyed AUG. 9 1978, by B. SUND