


T.35S., R.3W., W.M.

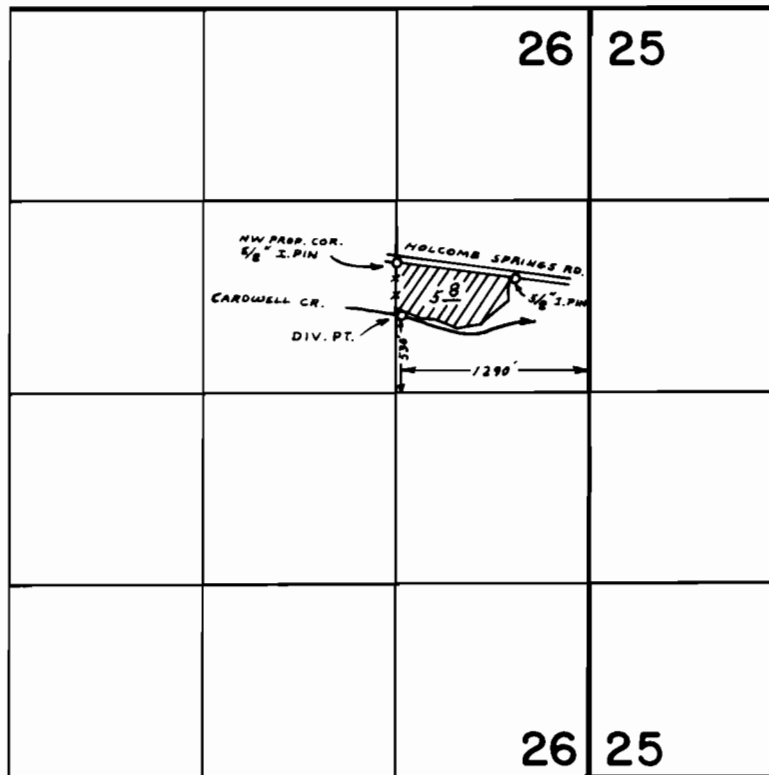

FINAL PROOF SURVEY
UNDER

Application No. 47381 Permit No. 35486
IN NAME OF

EDWARD & CAROL GREEN

Surveyed APR. 12 1978, by B. SUND