


East to wells

# T.40S. R.12E., W.M.

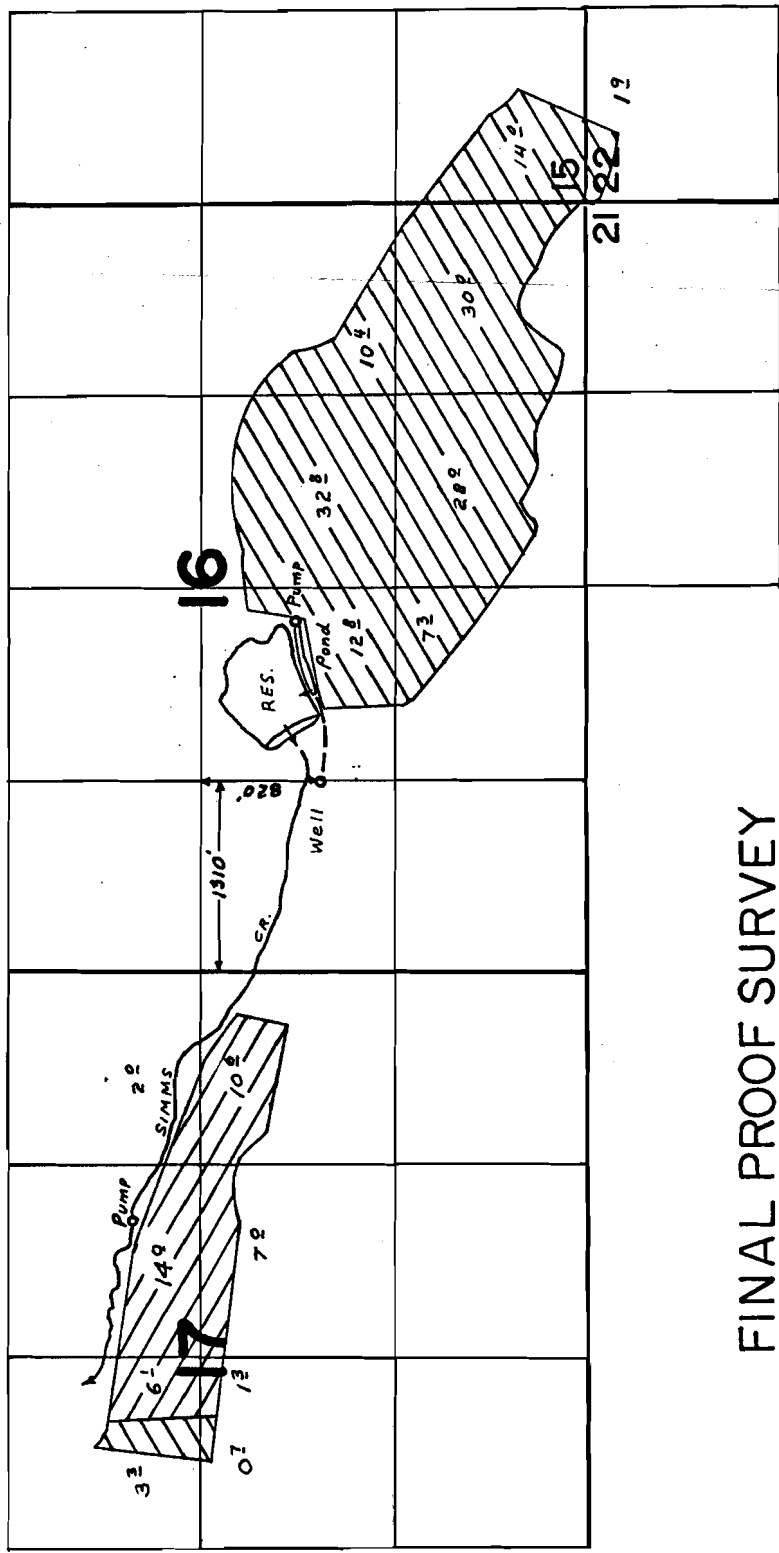

## FINAL PROOF SURVEY

UNDER

Application No. G-6236 Permit No. G-5882

IN NAME OF

WILLIAM RAJNUS, JR.

Surveyed JUL 31, 1978, by S. P. APPLIGATE