


-385 R9E
Upp. Kl. Lake wells

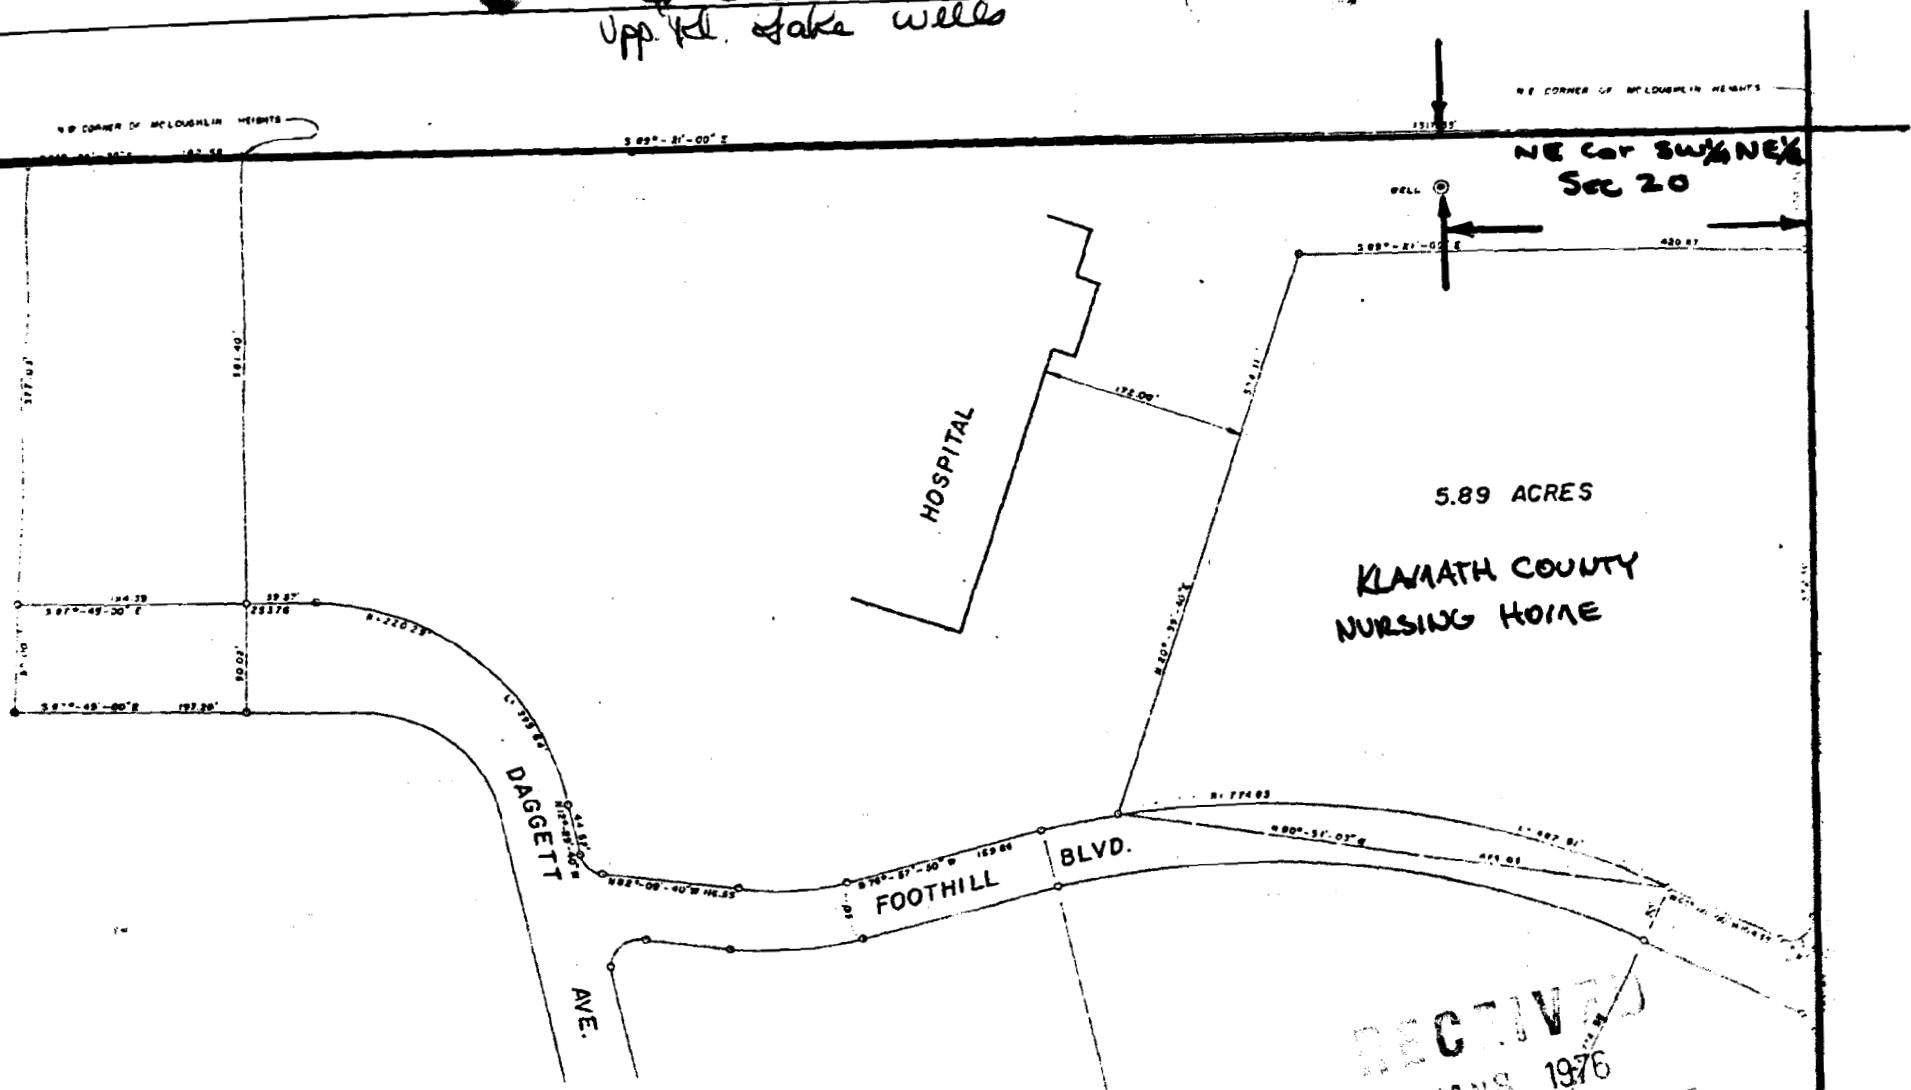

NE COR SW 1/4 NE 1/4
Sec 20

RECEIVED
JAN 8 1976
WATER RESOURCES DEPT.
SALEM, OREGON

Application No. G-7215
Permit No. G 7215

1" = 163'

48454
G-7215