


# T. 39S. R. 10E., W.M.

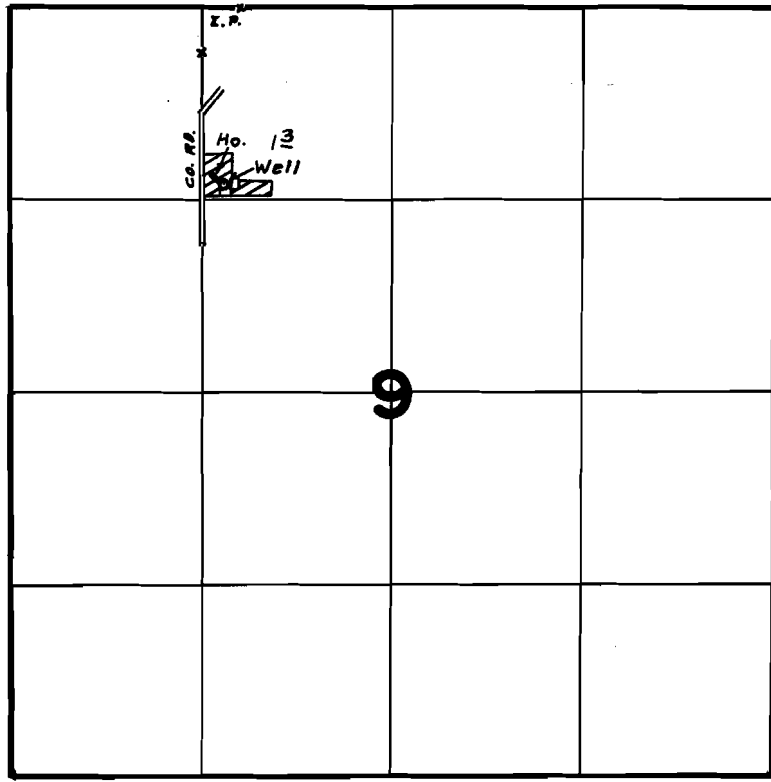

Well Loc 1220' S. & 150' E From N.E. Cor. NE\*NW\* Sec. 9

Just fu. wells

## FINAL PROOF SURVEY UNDER

Application No. G-8184... Permit No. G-7652...  
IN NAME OF

...LES. & DELILA PORTERFIELD...

Surveyed JUL...31... 1978., by S.P. APPLGATE