


T.38S.,R.7W.,W.M.

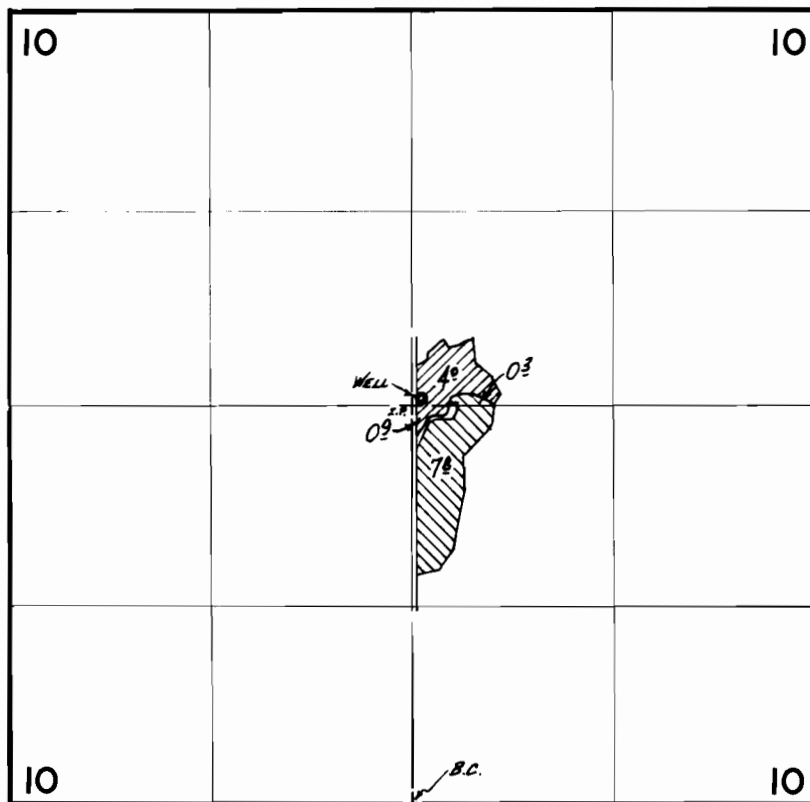

Primary



Supplemental

WELL LOCATED: 15' N. & 50' E. FROM CENTER SEC. 10.

FINAL PROOF SURVEY

UNDER

Application No. G-2543 Permit No. G-2354
IN NAME OF

EARLE A. JACKSON

Surveyed July 12 1963, by R. H. Jackson
Sept. 29 77 B. Sund

1963-K &
1977-14-B