


P# 37783
48463

T.39S.,R.20E.,W.M.

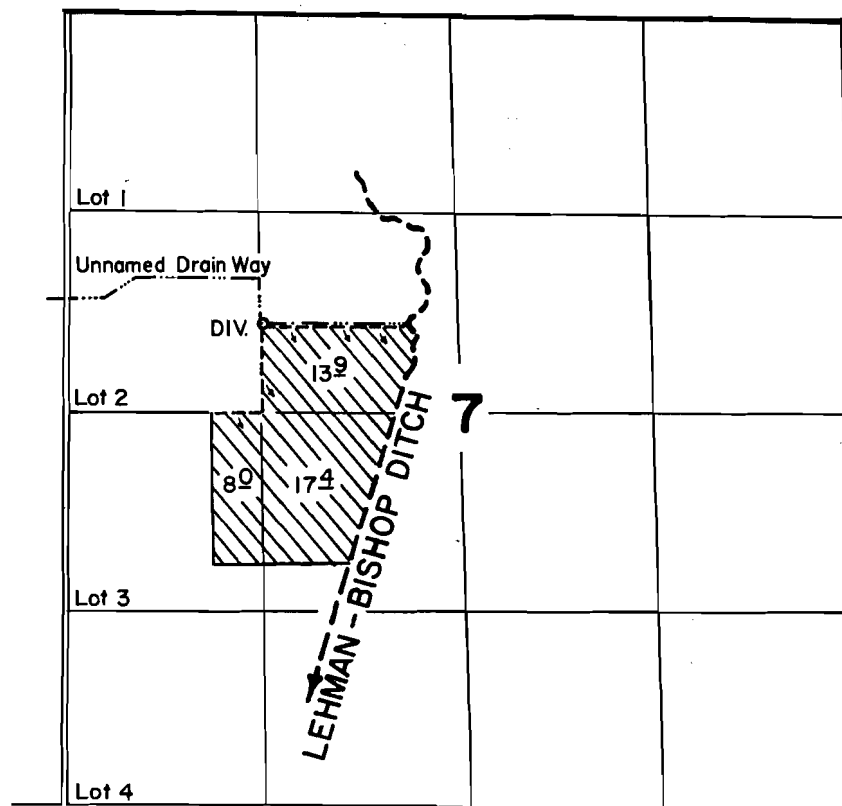

DIV. PT. LOC.: 620' N. & 20' E. FROM SW COR. SE 1/4 NW 1/4 SEC. 7

FINAL PROOF SURVEY
UNDER

Application No. 50522 Permit No. 37783
IN NAME OF

JERRY L. PATZKE

Surveyed OCT. 21, 1976, by R. MUCKEN