
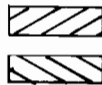


T.16S. R.4 W., W.M

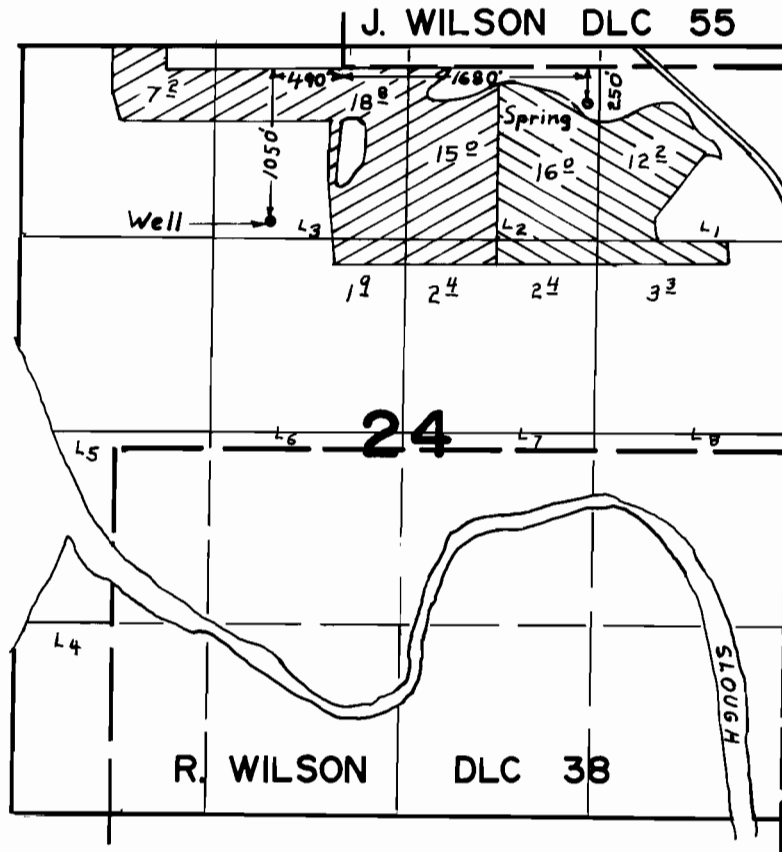

App'l. G-6328
App'l. 51349

FINAL PROOF SURVEY UNDER

G-6328 G-5940
Application No. 51349 Permit No. 38764
IN NAME OF

..... EDSEL W. CHASE

Surveyed SEP. 12. 1978. by J. S. DONALDSON