


T. 17S., R. 6 W., W.M.

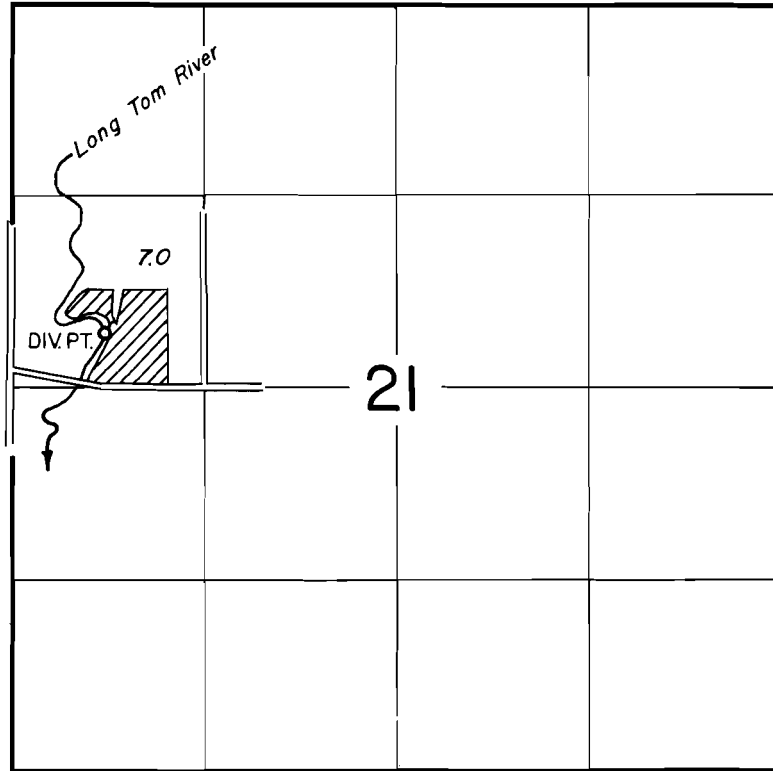

DIV. PT. LOC.: 360' N. & 640' E. From W. 1/4 Cor. Sec. 21

FINAL PROOF SURVEY
UNDER

Application No. 40790 Permit No. 30395
IN NAME OF

JAMES K. & AUDREY L. WRIGHT

Surveyed May 12, 1978, by L. NUNN