


T.20S., R.5W., W.M.

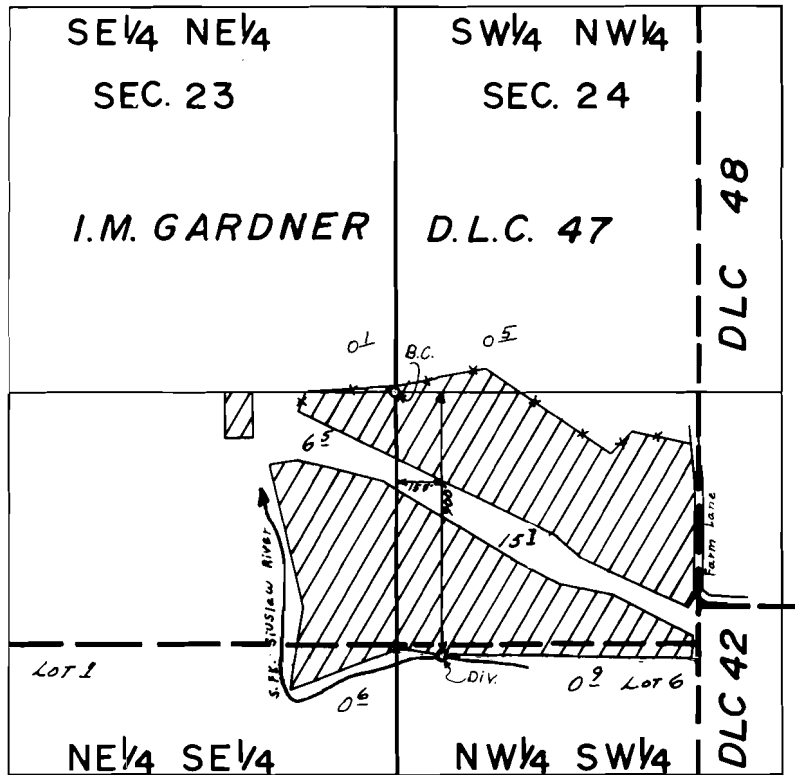

Scale - 1" = 660'

FINAL PROOF SURVEY
UNDER

Application No. 45910 Permit No. 34298
IN NAME OF

GERALD M. OR BEVERLY M. REICHER

Surveyed NOV. 1 1977, by D. W. SPARKS.