
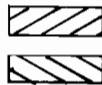


# T.16S. R.4 W., W.M

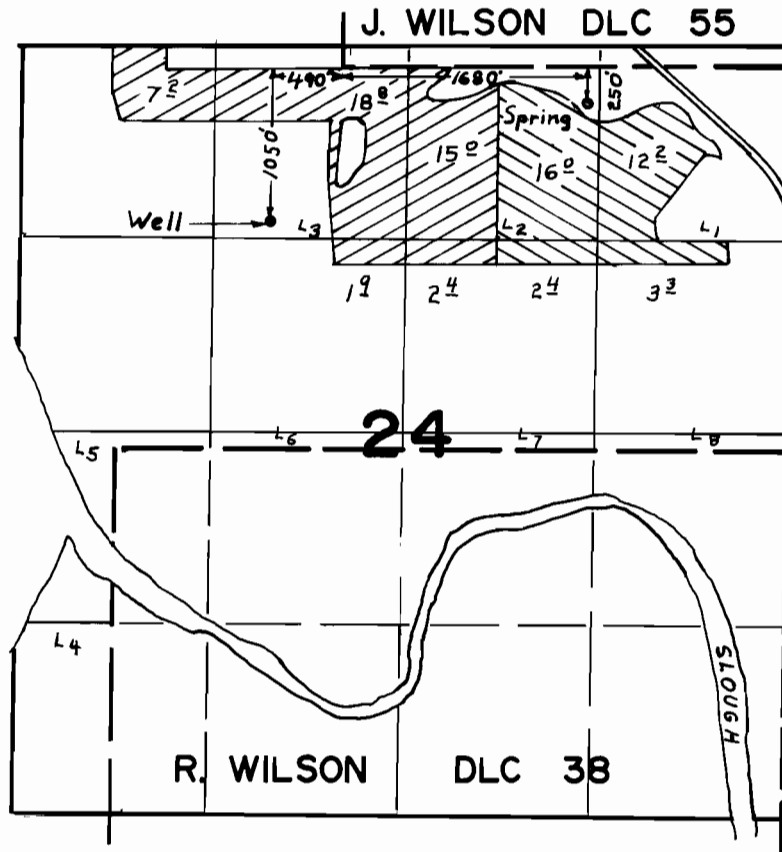

App'l. G-6328  
App'l. 51349

## FINAL PROOF SURVEY UNDER

G-6328                      G-5940  
Application No. 51349      Permit No. 38764  
IN NAME OF

..... EDSEL W. CHASE .....

Surveyed SEP. 12. 1978. by J.S. DONALDSON