


T.17S. R.5W. W.M.

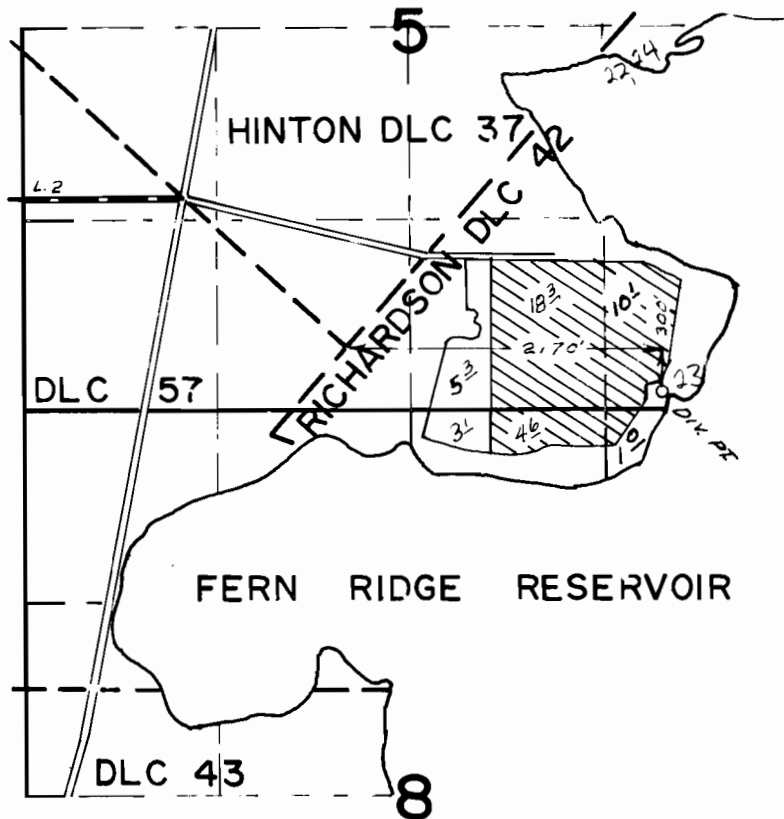

**FINAL PROOF SURVEY**  
UNDER

Application No. 51962..... Permit No. 37477.....  
IN NAME OF

..... LLOYD BANGS .....

Surveyed MAY 9..... 1978., by L.H. NUNN.....