


# T.18S. R.45E. W.M.

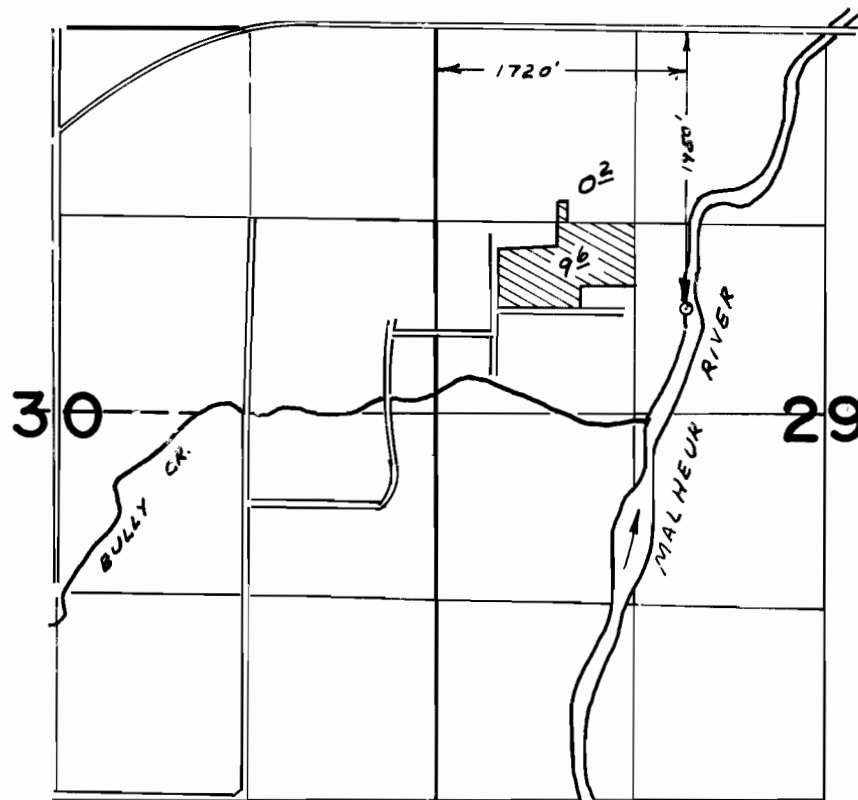

## FINAL PROOF SURVEY UNDER

Application No. 49877... Permit No. 37510.....  
IN NAME OF

VALE ELEMENTARY SCHOOL DIST. NO.15

Surveyed JUN. 27. 1978. by L.H. NUNN.....