


T.18S. R.46E. W.M.

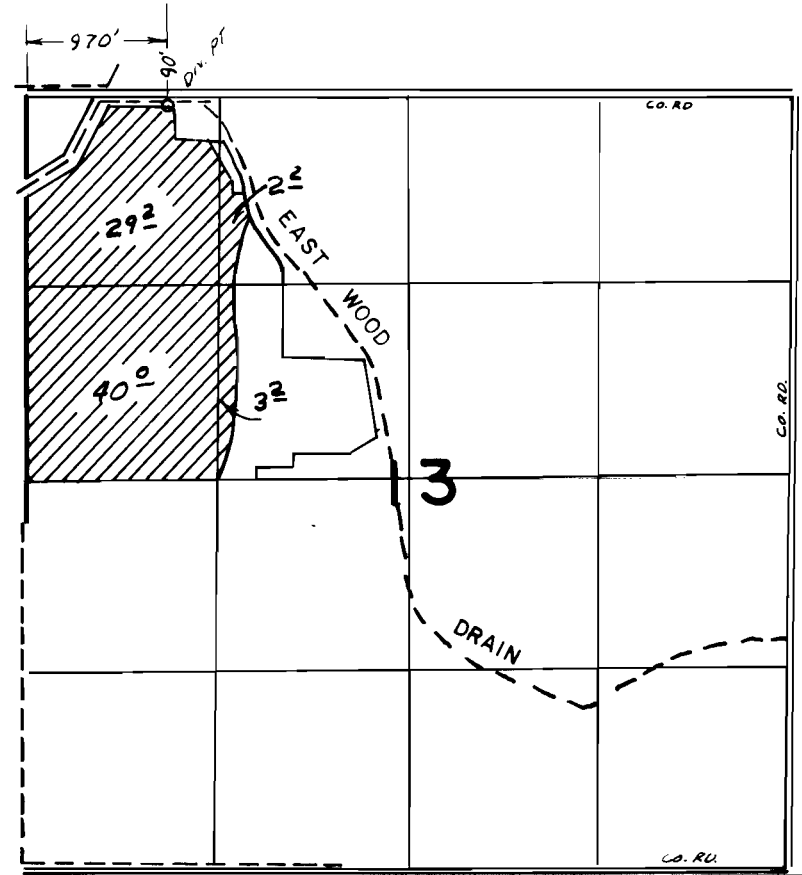

FINAL PROOF SURVEY UNDER

Application No. 55122..... Permit No. 42722.....
IN NAME OF

J.M. BLACKWELL.....

Surveyed JUN. 22. 1978., by L.H. NUNN.....