


# T. 6 S., R. 2 W., W.M.

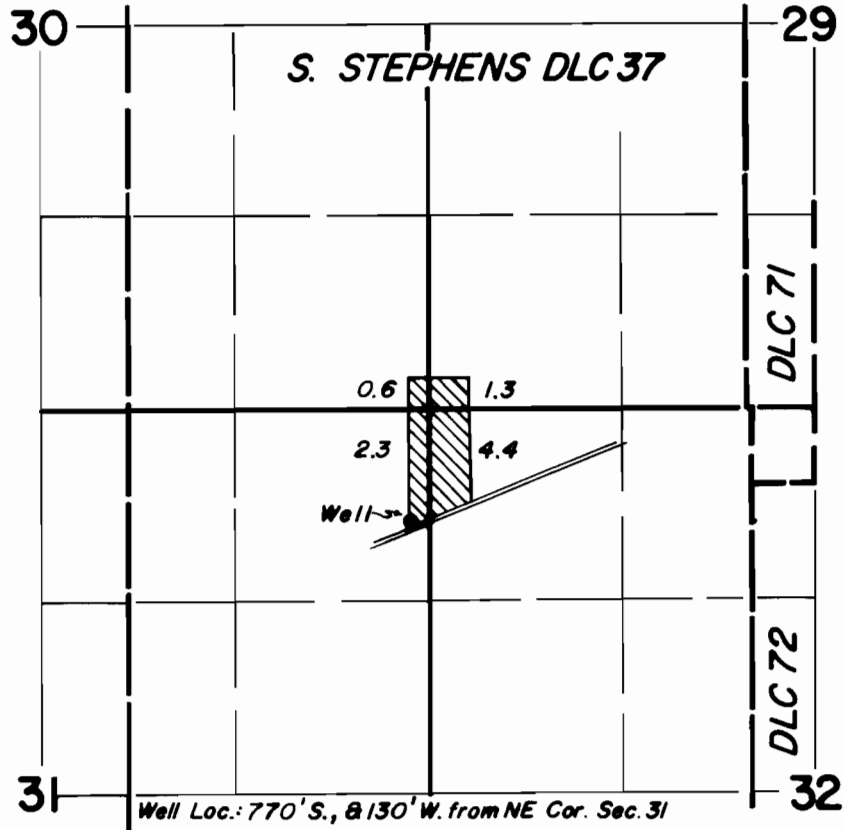

## FINAL PROOF SURVEY UNDER

Application No. G 5816 Permit No. G 5703  
IN NAME OF

TERRY L. & CORDELIA R. BIBBY

Surveyed AUG. 8., 1977. by B. SUND