


G-5796  
48477

T.33S. R.18E., W.M.

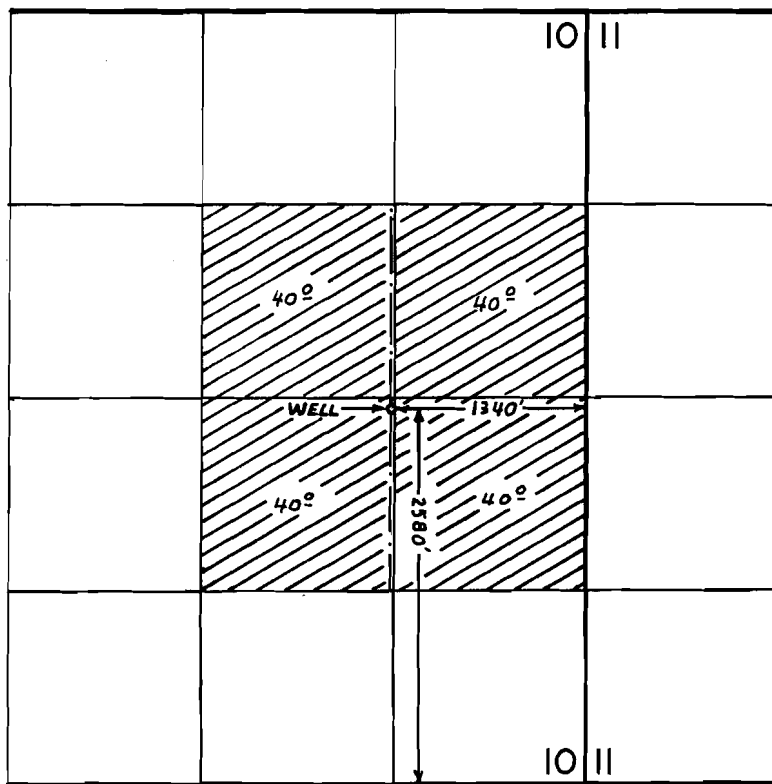

**FINAL PROOF SURVEY**  
UNDER

Application No. G-6125 Permit No. G-5796  
IN NAME OF

JOHN V. WITHERS

Surveyed JUL. 20., 19.7.7., by D.M. NORBY