The sketch below is made solely for the purpose of assisting in locating said premises and the Company assumes no liability for variations, if any, in dimensions and location ascertained by actual survey.

Pioneer National Title Insurance Company
Title and Trust Division

Application No. 54470
Permit No. 40858

THREE RIVERS

IN THE EAST 1/2 SEC 30, T.4S., R.9W. W.M.
TILLAMOOK COUNTY OREGON
SCALE: 1" = ~~200~~ 400' JUNE, 1969
Allen & Leuthold Inc

APPROVED June 24
TILLAMOOK COUNTY
COMMISSION
BY

APPROVED 6/27
COUNTY SURVEYOR

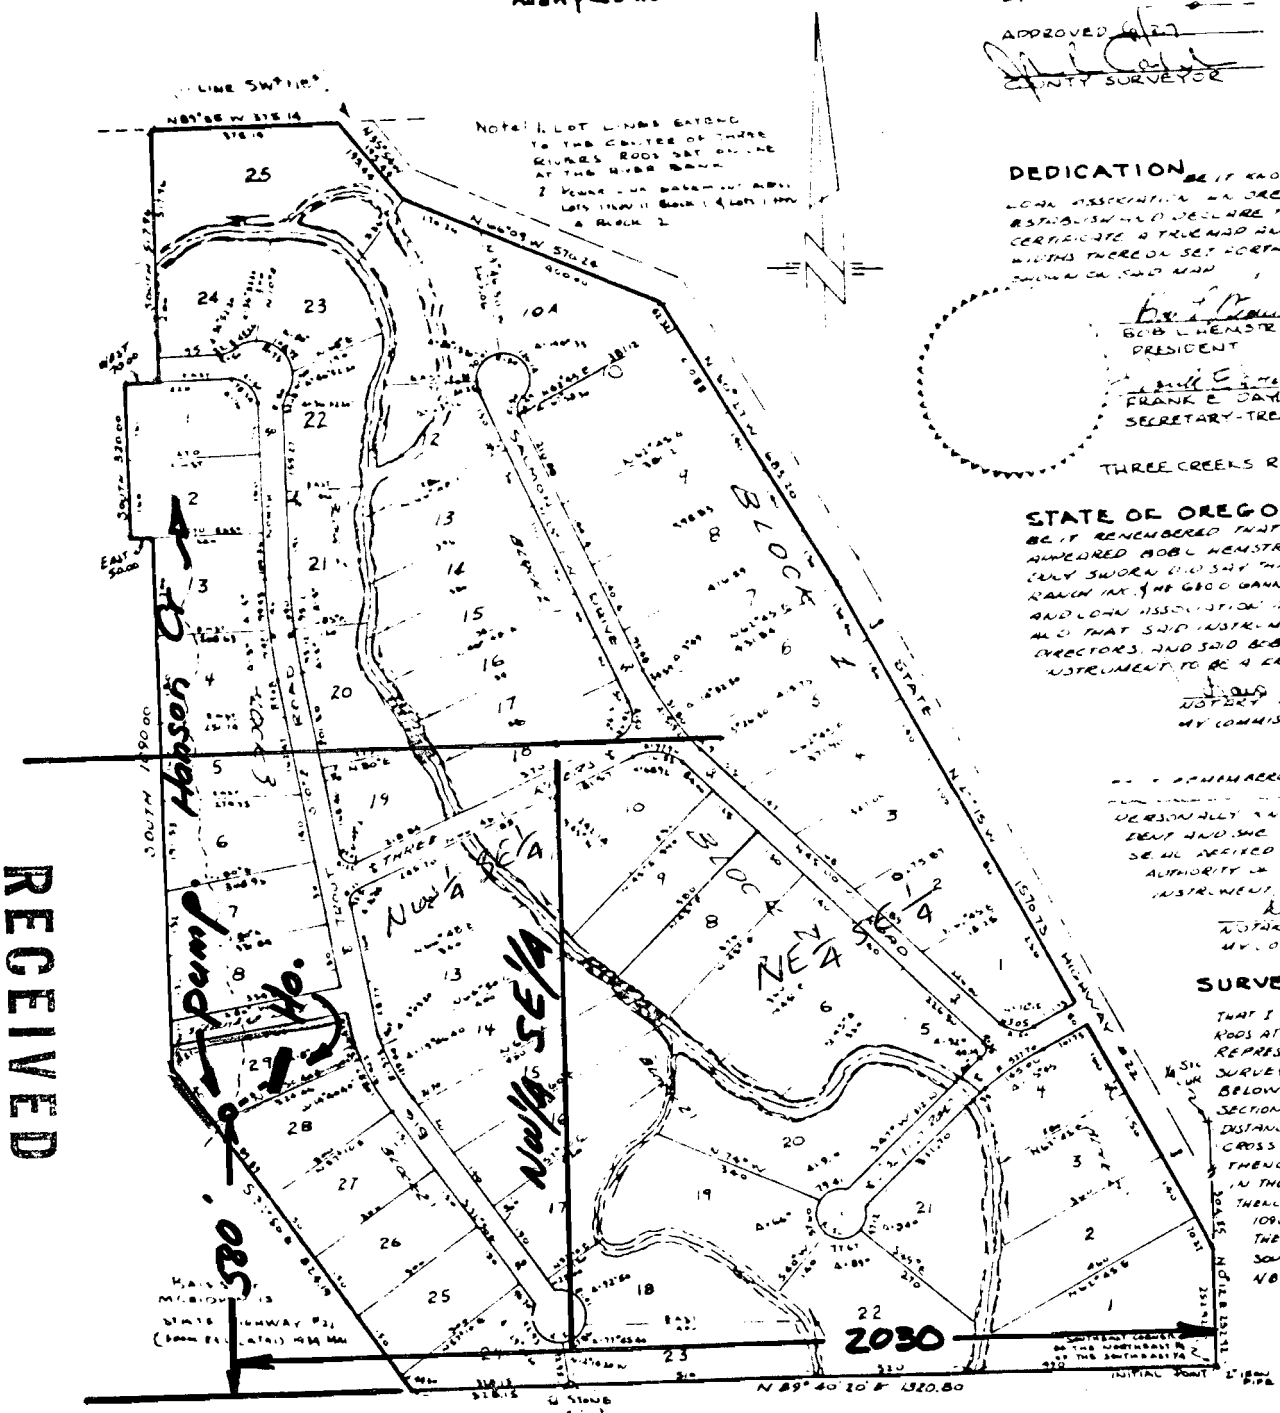

DEDICATION

BE IT KNOWN THAT ... ASSOCIATION OF OREGON ... ESTABLISHED AND DECLARE THE ... CERTIFICATE A TRUE AND ... WITHIN THEREON SET FORTH ... SHOWN ON SAID MAP

BOB L HEMSTREET
PRESIDENT

FRANK E. DAY
SECRETARY-TREASURER

THREE CREEKS RANCH ...

STATE OF OREGON, CO...

BE IT REMEMBERED THAT ON THIS ... HUNDRED AND BOB L HEMSTREET ... DULY SWORN DID SAY THAT HE ... RANCH INC. THE GOOD GANNETT ... AND COMMISSION ... AND THAT ... AND THAT SAID INSTRUMENT ... DIRECTORS, AND SAID BOB L HEMST... INSTRUMENT TO BE A FREE ...

NOTARY PUBLIC ...
MY COMMISSION EX...

BE IT REMEMBERED THAT ... OREGON ... AND SHE ... SEAL ... AUTHORITY ... INSTRUMENT ...

NOTARY PUBLIC ...
MY COMMISSION ...

SURVEYOR'S

THAT I HAVE COMP... RODS AT CURVE POI... REPRESENTED IN ... SURVEY I SET ... BELOW THE SURV... SECTION 30 T.4S ... DISTANCE OF 2529 ... CROSS COUNTY ... THENCE N.30°27' ... IN THE NORTH ... THENCE SOUTH ... 1090.00 FEET ... THENCE N89°40' ... SOUTHWEST CO... N89°40'20"E ...

SUBSCR... THIS ...

NOTARY ...
MY ...

RECEIVED
AUG 16 1976
WATER RESOURCES DEPT
SALEM, OREGON