


G-5485
48482

T.6N. R.34E. W.M.

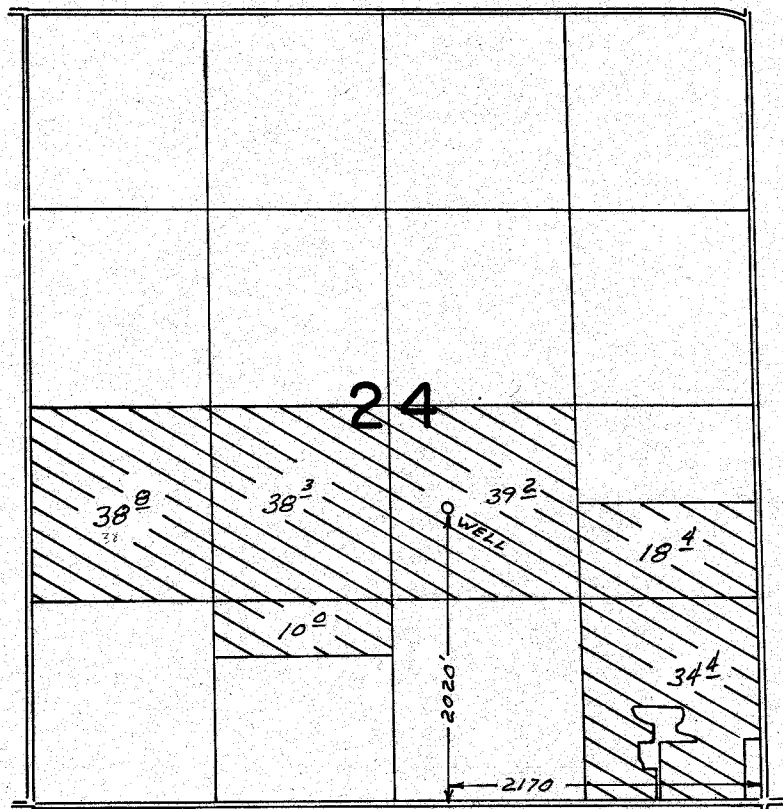

FINAL PROOF SURVEY UNDER

Application No. G-5658. Permit No. G-5485.
IN NAME OF

WEBSTER & WOODARD

Surveyed APR. 10. 1977, by L.H. NUNN