


T.4N. R.29E. W.M.

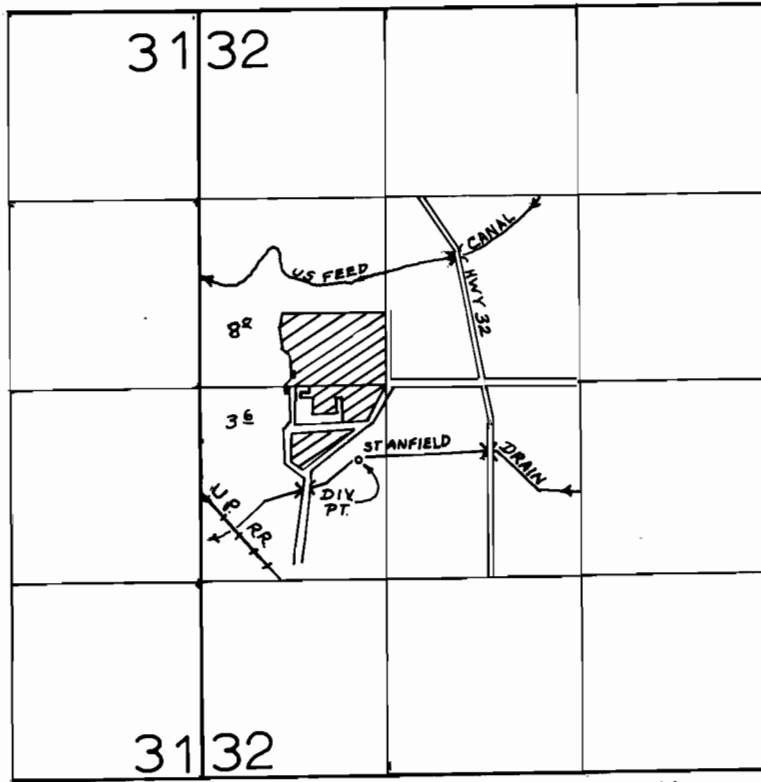

P.O.D. 200' W & 500' S FROM NE COR OF NW 1/4 OF SW 1/4 OF SEC 32

FINAL PROOF SURVEY
UNDER

Application No. 48070 Permit No. 36058
IN NAME OF
STANFIELD SCHOOL DIST. NO. 61

Surveyed NOV. 29. 1977., by R. BARWIN.....