


Application No. 54123  
Permit No. 40516

T.1 S.R.3 W. W.M.

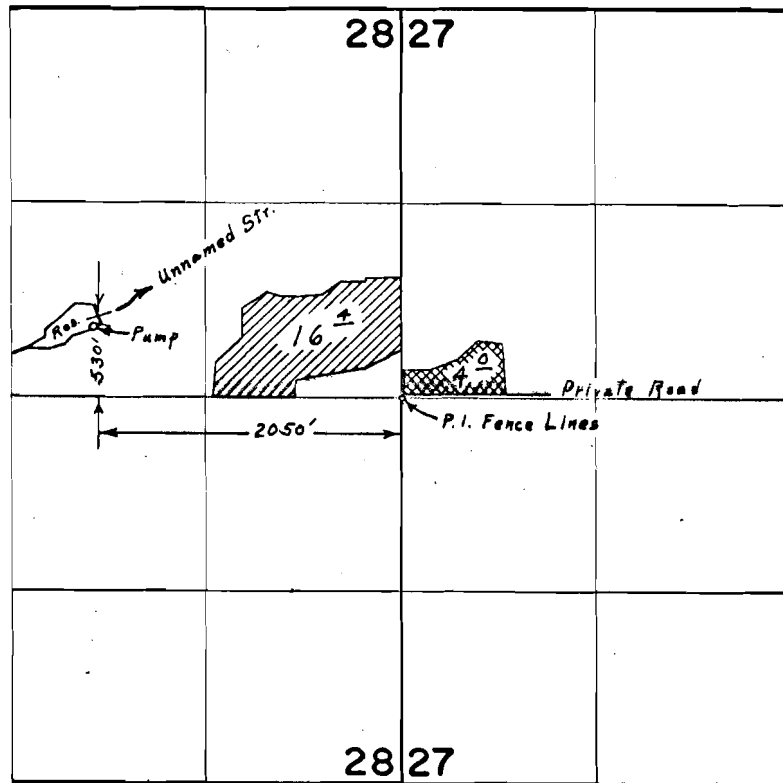

**FINAL PROOF SURVEY**  
UNDER

R-40502                      R-4582  
40503                      30447  
Application No. 42435    Permit No. 31750  
IN NAME OF

**CARL PIERSON**

Surveyed Sept. 14, 1967, by L. E. Gould